

CARD MUST BE TYPED

State of Kansas
NOTICE OF INTENTION TO DRILL
(see rules on reverse side)

CARD MUST BE SIGNED

Starting Date: 11 13 84
month day year

API Number 15- 001-27,082-00-00

OPERATOR: License # 5150
Name Mack C. Colt, Inc.
Address P.O. Box 388
City/State/Zip Iola, KS 66749
Contact Person Dennis Kershner
Phone 316-365-3111

. NE . SE . NE . Sec 21 . Twp . 23 S, Rge . 18 East
(location) West

3410 Ft North from Southeast Corner of Section
120 Ft West from Southeast Corner of Section
(Note: Locate well on Section Plat on reverse side)

CONTRACTOR: License # 5150
Name company tools
City/State

Nearest lease or unit boundary line 1180 feet.
County Allen
Lease Name IOOF (CBSU) Well# 6A

Well Drilled For: Well Class: Type Equipment:
 Oil Swd Infield Mud Rotary
 Gas Inj Pool Ext. Air Rotary
 OWWO Expl Wildcat Cable

Domestic well within 330 feet: yes no
Municipal well within one mile: yes no

If OWWO: old well info as follows:

Operator
Well Name
Comp Date Old Total Depth
Projected Total Depth 850 feet
Projected Formation at TD Squirrel
Expected Producing Formations Squirrel

Depth to Bottom of fresh water unknown feet
Lowest usable water formation unknown
Depth to Bottom of usable water 150 feet
Surface pipe by Alternate: 1 2
Surface pipe to be set none 20 feet
Conductor pipe if any required none feet
Ground surface elevation unknown feet MSL
This Authorization Expires 5-9-85
Approved By 11-9-84 [Signature]


I certify that we will comply with K.S.A. 55-101, et seq., plus eventually plugging hole to K.C.C. specifications.

Date 11-7-84 Signature of Operator or Agent [Signature]

Title PA
MHC/UDHE 11/9/84 Form C-1 4/84

Must be filed with the K.C.C. five (5) days prior to commencing well
 This card void if drilling not started within six (6) months of date received by K.C.C.

A Regular Section of Land
1 Mile = 5,280 Ft.

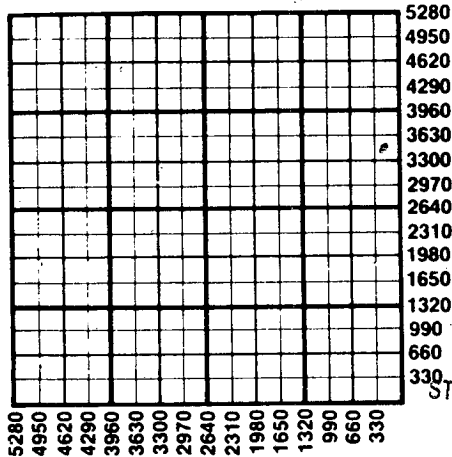

119-84

Important procedures to follow :

1. Notify District office before setting surface casing.
2. Set surface casing by circulating cement to the top.
3. File completion forms ACO-1 with K.C.C. within 90 days of well completion, following instructions on ACO-1, side 1, and including copies of wireline logs.
4. Notify District office 48 hours prior to old well workover or re-entry.
5. Prior to plugging, prepare a plugging plan, then obtain agreement from the appropriate district office for an approved plugging plan.
6. Submit plugging report (CP-4) to K.C.C. after plugging is completed.
7. Obtain an approved injection docket number before disposing of salt water.
8. Notify K.C.C. within 10 days when injection commences or terminates.

If an alternate 2 completion, cement in the production pipe from below any usable water to surface within 120 days of spud date.

RECEIVED
 STATE CORPORATION COMMISSION

NOV 09 1984

CONSERVATION DIVISION
 Wichita, Kansas

State Corporation Commission of Kansas
 Conservation Division
 200 Colorado Derby Building
 Wichita, Kansas 67202
 (316) 263-3238