

NOTICE OF INTENTION TO DRILL

(see rules on reverse side)

Starting Date Feb. 6, 1987 month day year

API Number 15- 099-22,532-00-00 NW SE

OPERATOR: License # 4690

N/E S/E Sec. 23. Twp. 32. S, Rg. 17. X East

Name Petro 85, Corp.

1100 Ft. from South Line of Section

Address Route 2

850 Ft. from East Line of Section

City/State/Zip Cherryvale, KS 67335

(Note: Locate well on Section Plat on reverse side)

Contact Person John Ellis

Nearest lease or unit boundary line 470 feet

Phone 316/336-2178

County Labette

CONTRACTOR: License # 4162

Lease Name Sale Well # 23

Name Gerstenkorn Oil Production

Ground surface elevation 800 feet MSL

City/State Independence, KS

Domestic well within 330 feet: yes X no

Well Drilled For: Well Class: Type Equipment:

Municipal well within one mile: yes X no

X Oil SWD Infield X Mud Rotary

Depth to bottom of fresh water 15'

Gas Inj X Pool Ext. Air Rotary

Depth to bottom of usable water 200'

OWWO Expl Wildcat Cable

Surface pipe by Alternate: 1 X

If OWWO: old well info as follows:

Surface pipe planned to be set 20'

Operator

Conductor pipe required

Well Name

Projected Total Depth 770' feet

Comp Date Old Total Depth

Formation Bartlesville

I certify that well will comply with K.S.A. 55-101, et seq., plus eventually plugging hole to KCC specifications.

Date 1/28/87 Signature of Operator or Agent Mike Harman Title President

For KCC Use:

Conductor Pipe Required feet; Minimum Surface Pipe Required 20 feet per Alt. 40

This Authorization Expires 8-2-87 Approved By 2-2-87


Handwritten signatures and initials at the bottom right of the page.

Must be filed with the K.C.C. five (5) days prior to commencing well  
This card void if drilling not started within six (6) months of date received by K.C.C.

### Important procedures to follow:

1. Notify District office before setting surface casing.
2. Set surface casing by circulating cement to the top.
3. File completion forms ACO-1 with K.C.C. within 90 days of well completion, following instructions on ACO-1, side 1, and including copies of wireline logs.
4. Notify District office 48 hours prior to old well workover or re-entry.
5. Prior to filing Intent, prepare a proposed plugging plan in case well is D & A, then obtain approval of plan when calling district office prior to setting surface pipe.
6. Submit plugging report (CP-4) to K.C.C. after plugging is completed.
7. Obtain an approved injection docket number before disposing of salt water.
8. Notify K.C.C. within 10 days when injection commences or terminates.
9. If an alternate 2 completion, cement in the production pipe from below any usable water to surface within 120 days of spud date.

### A Regular Section of Land 1 Mile = 5,280 Ft.

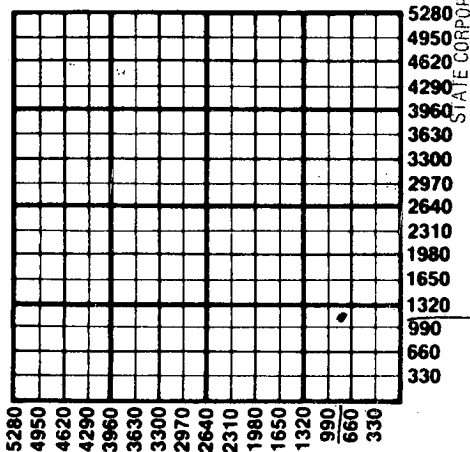

FEB 2 1987

CONSERVATION DIVISION  
Wichita, Kansas

22-87

State Corporation Commission of Kansas  
Conservation Division  
200 Colorado Derby Building  
Wichita, Kansas 67202  
(316) 263-3238