

CARD MUST BE TYPED

State of Kansas

CARD MUST BE SIGNED

NOTICE OF INTENTION TO DRILL

(see rules on reverse side)

Starting Date 29 JULY 87
 month day year

API Number 15—

099-22, 585-0000

OPERATOR: License # 4469
 Name KELT ENERGY, INC.
 Address 900 COLLEGE AVE.
 City/State/Zip INDEPENDENCE, KS 67301
 Contact Person PETE JOHNSON
 Phone (316) 331-0207

CONTRACTOR: License #
 Name UNKNOWN
 City/State

Well Drilled For: Well Class: Type Equipment:
☒ Oil ☐ SWD ☒ Infield ☒ Mud Rotary
☐ Gas ☐ Inj. ☐ Pool Ext. ☐ Air Rotary
☐ OWWO ☐ Expl ☐ Wildcat ☐ Cable

If OWWO: old well info as follows:

Operator NA
 Well Name
 Comp Date Old Total Depth

I certify that well will comply with K.S.A. 55-101, et seq., plus eventually plugging hole to KCC specifications.

Date ... 24 July 87 ... Signature of Operator or Agent Title AGENT

For KCC Use:

Conductor Pipe Required feet; Minimum Surface Pipe Required feet per Alt. X 2
 This Authorization Expires 1-27-88 Approved By 7-27-87

Appr. E/2 SE SW Sec. 23 Twp. 32S, Rg. 17E. — East
 875 Ft. from South Line of Section
 2790 Ft. from East Line of Section

(Note: Locate well on Section Plat on reverse side)


Nearest lease or unit boundary line 875 feet
 County LABETTE
 Lease Name UTTER Well # KCPU 5
 Ground surface elevation 820 feet MSL
 Domestic well within 330 feet:yes ☒no
 Municipal well within one mile:yes ☒no
 Depth to bottom of fresh water
 Depth to bottom of usable water 200
 Surface pipe by Alternate: 1 ☐ 2 ☒
 Surface pipe planned to be set 20
 Conductor pipe required NA
 Projected Total Depth 750 feet
 Formation BARTLESVILLE

Must be filed with the K.C.C. five (5) days prior to commencing well
This card void if drilling not started within six (6) months of date received by K.C.C.

Important procedures to follow:

1. Notify District office before setting surface casing.
2. Set surface casing by circulating cement to the top.
3. File completion forms ACO-1 with K.C.C. within 90 days of well completion, following instructions on ACO-1, side 1, and including copies of wireline logs.
4. Notify District office 48 hours prior to old well workover or re-entry.
5. Prior to filing Intent, prepare a proposed plugging plan in case well is D & A, then obtain approval of plan when calling district office prior to setting surface pipe.
6. Submit plugging report (CP-4) to K.C.C. after plugging is completed.
7. Obtain an approved injection docket number before disposing of salt water.
8. Notify K.C.C. within 10 days when injection commences or terminates.
9. If an alternate 2 completion, cement in the production pipe from below any usable water to surface within 120 days of spud date.

**A Regular Section of Land
1 Mile = 5,280 Ft.**

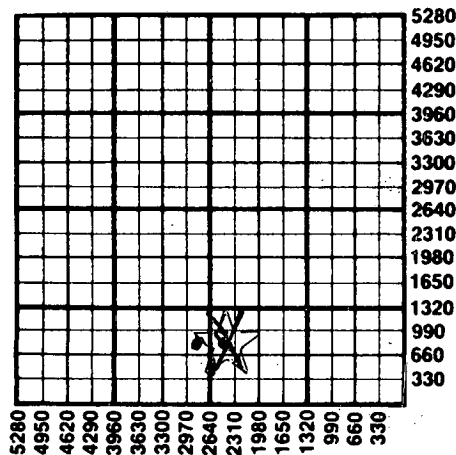

CONSERV
Wichita, Kansas
ON

JUL 27 1987

STATE CORPORATION COMMISSION

State Corporation Commission of Kansas
Conservation Division
200 Colorado Derby Building
Wichita, Kansas 67202
(316) 263-3238

7-27-87