

NOTICE OF INTENTION TO DRILL

(see rules on reverse side)

Starting Date 29 July 87 month day year

API Number 15- 099-22, 586-00-00

OPERATOR: License # 4469 Name KELT ENERGY, INC. Address 900 COLLEGE AVE. City/State/Zip INDEPENDENCE, KS. 67301 Contact Person PETE JOHNSON Phone (316) 331-0207

W/2 SW SE... Sec... 23 Twp... 32Ss, Rg... 17E. 875 Ft. from South Line of Section 2320 Ft. from East Line of Section

(Note: Locate well on Section Plat on reverse side)

CONTRACTOR: License # Name UNKNOWN City/State

Nearest lease or unit boundary line 875 feet County LABETTE

Lease Name UTTER Well # KCPU 4

Ground surface elevation 820 feet MSL

Domestic well within 330 feet: yes X no

Municipal well within one mile: yes X no

Depth to bottom of fresh water

Depth to bottom of usable water 200

Surface pipe by Alternate: 1 2 X

Surface pipe planned to be set 20

Conductor pipe required NA

Projected Total Depth 750 feet

Formation BARTLESVILLE

If OWWO: old well info as follows:

Operator NA

Well Name

Comp Date Old Total Depth

I certify that well will comply with K.S.A. 55-101, et seq., plus eventually plugging hole to KCC specifications.

Date 24 July 87 Signature of Operator or Agent P. Hyllie, D. Austin Title AGENT

For KCC Use:

Conductor Pipe Required feet; Minimum Surface Pipe Required 20 feet per Alt. X 2


This Authorization Expires 1-27-88 Approved By JH 7-27-87

Must be filed with the K.C.C. five (5) days prior to commencing well  
This card void if drilling not started within six (6) months of date received by K.C.C.

**Important procedures to follow:**

1. Notify District office before setting surface casing.
2. Set surface casing by circulating cement to the top.
3. File completion forms ACO-1 with K.C.C. within 90 days of well completion, following instructions on ACO-1, side 1, and including copies of wireline logs.
4. Notify District office 48 hours prior to old well workover or re-entry.
5. Prior to filing Intent, prepare a proposed plugging plan in case well is D & A, then obtain approval of plan when calling district office prior to setting surface pipe.
6. Submit plugging report (CP-4) to K.C.C. after plugging is completed.
7. Obtain an approved injection docket number before disposing of salt water.
8. Notify K.C.C. within 10 days when injection commences or terminates.
9. If an alternate 2 completion, cement in the production pipe from below any usable water to surface within 120 days of spud date.

**A Regular Section of Land  
1 Mile = 5,280 Ft.**

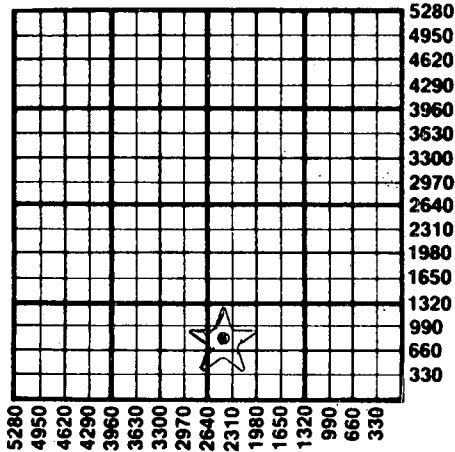

CONSERVATION DIVISION  
Wichita, Kansas

APR 27 1987

STATE CORPORATION COMMISSION

State Corporation Commission of Kansas  
Conservation Division  
200 Colorado Derby Building  
Wichita, Kansas 67202  
(316) 263-3238

7-27-87