

CARD MUST BE TYPED

State of Kansas

CARD MUST BE SIGNED

NOTICE OF INTENTION TO DRILL

Corrected
No pit - Air rotary

(see rules on reverse side)

Expected Spud Date... 11 month 11 day 88 year

API Number 15- 099-22,722 -00-00

OPERATOR: License # 5499
Name Brecheisen Oil Company
Address Box 40
City/State/Zip Garnett, Kansas 66032
Contact Person A. W. Brecheisen
Phone 913-448-6952

Approx- NE. NE... NW Sec. 14 Twp. 31 S, Rg. 18
*4850 Ft. from South Line of Section
*3070 Ft. from East Line of Section

CONTRACTOR: License # 5379
Name Kephart Drilling, Inc.
City/State R. 1 Thayer, Kansas 66776

(Note: Locate well on Section Plat on reverse side)
Nearest lease or unit boundary line *430 feet
County Labette
Lease Name Scott Well # 2

Well Drilled For: Well Class: Type Equipment:
Oil Storage Infield Mud Rotary
 Gas Inj Pool Ext. Air Rotary
 OWWO Expl Wildcat Cable

Ground surface elevation feet MSL
Domestic well within 330 feet: yes no
Municipal well within one mile: yes no
Depth to bottom of fresh water 30'
Depth to bottom of usable water 200'
Surface pipe by Alternate: 1 2
Surface pipe planned to be set 21'
Conductor pipe required none
Projected Total Depth 375 feet
Formation Dennis sand

If OWWO: old well info as follows:
Operator
Well Name
Comp Date Old Total Depth

I certify that well will comply with K.S.A. 55-101, et seq., plus eventually plugging hole to KCC specifications.
Date 12/19/88 Signature of Operator or Agent Lois Nay Title Acting agent

For KCC Use:
Conductor Pipe Required feet; Minimum Surface Pipe Required 20' feet per Alt. * 2
This Authorization Expires 5-4-89 Approved By LKM 12-21-88 ORIG. PERM: 11-4-88

EFFECTIVE DATE: 11-9-88


* WAS: 3960' FSL, 2970' FEL, 330' FROM LEASE LINE

Must be filed with the K.C.C. five (5) days prior to commencing well
This card void if drilling not started within six (6) months of date received by K.C.C.

Important procedures to follow:

1. Notify District office before setting surface casing.
 2. Set surface casing by circulating cement to the top.
 3. File completion forms ACO-1 with K.C.C. within 120 days of well spud date, following instructions on ACO-1, side 1, and including copies of wireline logs.
 4. Notify District office 48 hours prior to old well workover or re-entry.
 5. Prior to filing Intent, prepare a proposed plugging plan in case well is D & A, then obtain approval of plan when calling district office prior to setting surface pipe.
 6. Submit plugging report (CP-4) to K.C.C. after plugging is completed.
 7. Obtain an approved injection docket number before disposing of salt water.
9. If an alternate 2 completion, cement in the production pipe from below any usable water to surface within 120 days of spud date.

A Regular Section of Land
1 Mile = 5,280 Ft.

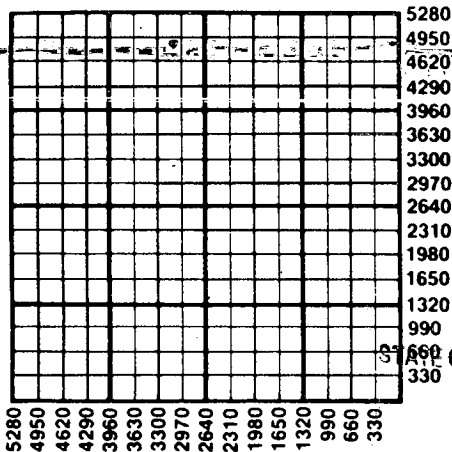

RECEIVED
STATE CORPORATION COMMISSION

CONSERVATION DIVISION
Wichita, Kansas

12-21-88

State Corporation Commission of Kansas
Conservation Division
200 Colorado Derby Building
Wichita, Kansas 67202-1212
(316) 263-3238

DEC 21 1988