

CARD MUST BE TYPED

State of Kansas
NOTICE OF INTENTION TO DRILL
(see rules on reverse side)

CARD MUST BE SIGNED

Starting Date: November 26, 1984
month day year

API Number 15- 099-22,222-0000

OPERATOR: License # 9015

SW SE SE Sec 24 Twp 31 S, Rge 18
(location) East West

Name INCO Energy Inc.

Address P. O. Box 379

City/State/Zip Parsons, Kansas 67357

Contact Person E. H. Hare, Jr.

Phone 316-421-0910

330 Ft North from Southeast Corner of Section

990 Ft West from Southeast Corner of Section

(Note: Locate well on Section Plat on reverse side)

CONTRACTOR: License # 5782

Name V W & B Drilling

City/State Cherryvale, Kansas 67335

Nearest lease or unit boundary line 330 feet.

County Labette

Lease Name J. Ludwig (534) Well# 24-1

Domestic well within 330 feet: yes no

Municipal well within one mile: yes no

Well Drilled For: Well Class: Type Equipment:

Oil Swd Infield Mud Rotary

Gas Inj Pool Ext. Air Rotary

OWWO Expl Wildcat Cable

Depth to Bottom of fresh water 25 feet

Lowest usable water formation

Depth to Bottom of usable water 150 feet

Surface pipe by Alternate: 1 2

Surface pipe to be set 20 feet

Conductor pipe if any required NONE feet

Ground surface elevation +983 Topo feet MSL

This Authorization Expires 5-19-85

Approved By 11-19-84

If OWWO: old well info as follows:

Operator

Well Name

Comp Date Old Total Depth

Projected Total Depth 1000' feet

Projected Formation at TD Mississippian

Expected Producing Formations Weiser/Bartlesville/Mississippian

I certify that we will comply with K.S.A. 55-101, et seq., plus eventually plugging hole to K.C.C. specifications.

Date 11-16-84 Signature of Operator or Agent

Title General Manager


Form C-1 4/84

MHC/KOHE 11/19/84

**Must be filed with the K.C.C. five (5) days prior to commencing well
This card void if drilling not started within six (6) months of date received by K.C.C.**

Important procedures to follow:

**A Regular Section of Land
1 Mile = 5,280 Ft.**

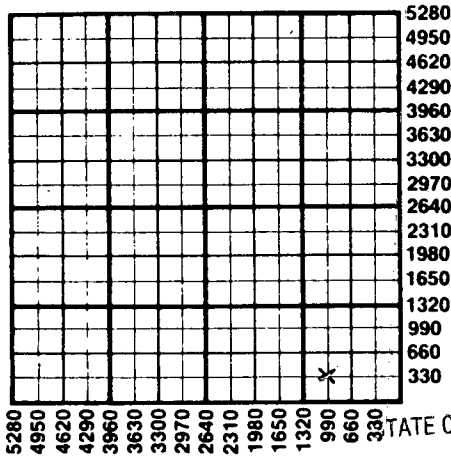

1. Notify District office before setting surface casing.
2. Set surface casing by circulating cement to the top.
3. File completion forms ACO-1 with K.C.C. within 90 days of well completion, following instructions on ACO-1, side 1, and including copies of wireline logs.
4. Notify District office 48 hours prior to old well workover or re-entry.
5. Prior to plugging, prepare a plugging plan, then obtain agreement from the appropriate district office for an approved plugging plan.
6. Submit plugging report (CP-4) to K.C.C. after plugging is completed.
7. Obtain an approved injection docket number before disposing of salt water.
8. Notify K.C.C. within 10 days when injection commences or terminates.
9. If an alternate 2 completion, cement in the production pipe from below any usable water to surface within 120 days of spud date.

RECEIVED
STATE CORPORATION COMMISSION

NOV 19 1984
11-19-84
CONSERVATION DIVISION
Wichita, Kansas

**State Corporation Commission of Kansas
Conservation Division
200 Colorado Derby Building
Wichita, Kansas 67202
(316) 263-3238**