

CORRECTED

For KCC Use: Effective Date: 11-13-06 District # 2 SGA? Yes No

KANSAS CORPORATION COMMISSION OIL & GAS CONSERVATION DIVISION

CORRECTED

Form C-1 October 2007

Form must be Typed Form must be Signed All blanks must be Filled

NOTICE OF INTENT TO DRILL

Must be approved by KCC five (5) days prior to commencing well

Expected Spud Date: November 12 2006 month day year

OPERATOR: License# 32563 Millennium Oil & Gas Inc Name: Millennium Oil & Gas Inc Address 1: 20790 K-15 Highway Address 2: P O Box 70 City: Dexter State: KS Zip: 67038 Contact Person: Robert W Bowers Phone: 620-876-3441

CONTRACTOR: License# 33557 Name: SKYY Drilling

Well Drilled For: Oil Gas Seismic Other Well Class: Infield Pool Ext Wildcat Other Type Equipment: Mud Rotary Air Rotary Cable

Operator: Well Name: Original Completion Date: Original Total Depth:

Directional, Deviated or Horizontal wellbore? If Yes, true vertical depth: Bottom Hole Location: KCC DKT #:

*WAS: N2 SE NE NE 800' FNL; 330' FEL IS: NE-SW-SW 839' FSL; 4221 FEL

Spot Description: NE SW Sec. 24 Twp. 34 S. R. 6 feet from N / S Line of Section feet from E / W Line of Section

Is SECTION: Regular Irregular (Note: Locate well on the Section Plat on reverse side)

County: Cowley Lease Name: Barnett Well #: 2A Field Name: Otto

Is this a Prorated / Spaced Field? Target Formation(s): Arbuckle

Nearest Lease or unit boundary line (in footage): 330 Ground Surface Elevation: 1375 feet MSL

Water well within one-quarter mile: Public water supply well within one mile:

Depth to bottom of fresh water: 150 Depth to bottom of usable water: 280

Surface Pipe by Alternate: I II Length of Surface Pipe Planned to be set: 300+

Length of Conductor Pipe (if any): none Projected Total Depth: 3400'

Formation at Total Depth: Arbuckle Water Source for Drilling Operations: Well Farm Pond Other:

DWR Permit #: (Note: Apply for Permit with DWR)

Will Cores be taken? If Yes, proposed zone:

AFFIDAVIT

The undersigned hereby affirms that the drilling, completion and eventual plugging of this well will comply with K.S.A. 55 et. seq. It is agreed that the following minimum requirements will be met:

- 1. Notify the appropriate district office prior to spudding of well; 2. A copy of the approved notice of intent to drill shall be posted on each drilling rig; 3. The minimum amount of surface pipe as specified below shall be set by circulating cement to the top; in all cases surface pipe shall be set through all unconsolidated materials plus a minimum of 20 feet into the underlying formation. 4. If the well is dry hole, an agreement between the operator and the district office on plug length and placement is necessary prior to plugging; 5. The appropriate district office will be notified before well is either plugged or production casing is cemented in; 6. If an ALTERNATE II COMPLETION, production pipe shall be cemented from below any usable water to surface within 120 DAYS of spud date. Or pursuant to Appendix "B" - Eastern Kansas surface casing order #133,891-C, which applies to the KCC District 3 area, alternate II cementing must be completed within 30 days of the spud date or the well shall be plugged. In all cases, NOTIFY district office prior to any cementing.

I hereby certify that the statements made herein are true and correct to the best of my knowledge and belief.

Date: June 12, 2008 Signature of Operator or Agent: Title: agent

For KCC Use ONLY API # 15 - 03524263-0000 Conductor pipe required None feet Minimum surface pipe required 300 feet per ALT. Approved by: This authorization expires: 5-8-07 Spud date: Agent:

Remember to: File Drill Pit Application (form CDP-1) with Intent to Drill; File Completion Form ACO-1 within 120 days of spud date; File acreage attribution plat according to field proration orders; Notify appropriate district office 48 hours prior to workover or re-entry; Submit plugging report (CP-4) after plugging is completed (within 60 days); Obtain written approval before disposing or injecting salt water. If this permit has expired (See: authorized expiration date) please check the box below and return to the address below. Well Not Drilled - Permit Expired Date: Signature of Operator or Agent:

Mail to: KCC - Conservation Division, 130 S. Market - Room 2078, Wichita, Kansas 67202

RECEIVED KANSAS CORPORATION COMMISSION

JUN 13 2008

CONSERVATION DIVISION WICHITA, KS

24 34 6

IN ALL CASES PLOT THE INTENDED WELL ON THE PLAT BELOW **CORRECTED**

Plat of acreage attributable to a well in a prorated or spaced field

If the intended well is in a prorated or spaced field, please fully complete this side of the form. If the intended well is in a prorated or spaced field complete the plat below showing that the well will be properly located in relationship to other wells producing from the common source of supply. Please show all the wells and within 1 mile of the boundaries of the proposed acreage attribution unit for gas wells and within 1/2 mile of the boundaries of the proposed acreage attribution unit for oil wells.

API No. 15 - 035-24263-0000
Operator: Millennium Oil & Gas Inc
Lease: Barnett
Well Number: 2A
Field: Otto

Location of Well: County: Cowley
839 feet from N / S Line of Section
4,221 feet from E / W Line of Section
Sec. 24 Twp. 34 S. R. 6 E W

Number of Acres attributable to well: _____
QTR/QTR/QTR/QTR of acreage: N2SE - NE - NE -


Is Section: Regular or Irregular

If Section is Irregular, locate well from nearest corner boundary.


Section corner used: NE NW SE SW

PLAT

(Show location of the well and shade attributable acreage for prorated or spaced wells.)
(Show footage to the nearest lease or unit boundary line.)

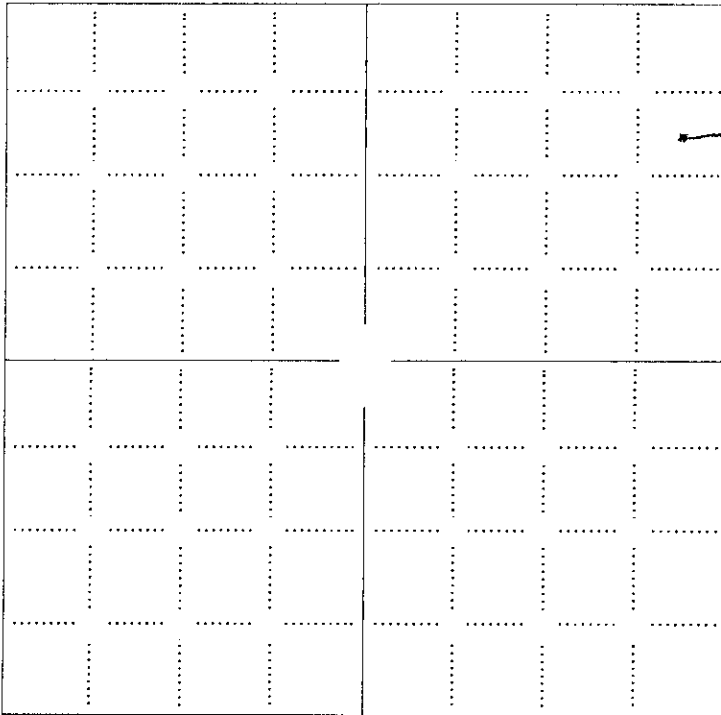

RECEIVED
KANSAS CORPORATION COMMISSION
JUN 13 2008
CONSERVATION DIVISION
WICHITA, KS

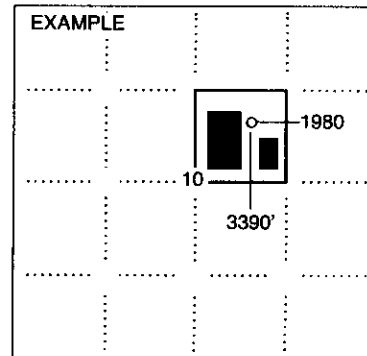

SEWARD CO.

NOTE: In all cases locate the spot of the proposed drilling location.

In plotting the proposed location of the well, you must show:

1. The manner in which you are using the depicted plat by identifying section lines, i.e. 1 section, 1 section with 8 surrounding sections, 4 sections, etc.
2. The distance of the proposed drilling location from the south / north and east / west outside section lines.
3. The distance to the nearest lease or unit boundary line (in footage).
4. If proposed location is located within a prorated or spaced field a certificate of acreage attribution plat must be attached: (CO-7 for oil wells; CG-8 for gas wells).