

15-Cas 07746-0000


STATE OF KANSAS
STATE CORPORATION COMMISSION

Form CP-4

Give All Information Completely
Make Required Affidavit
Mail or Deliver Report to:
Conservation Division
State Corporation Commission
211 No. Broadway
Wichita, Kansas

WELL PLUGGING RECORD

Graham County, Sec. 3 Twp. 8 Rge. 24 (E) (W)
Location as "NE/CNW/SW" or footage from lines SE NE SW
Lease Owner John O. Farmer, Inc.
Lease Name Goff Well No. 4
Office Address 370 West Wichita Russell, Kansas
Character of Well (completed as Oil, Gas or Dry Hole) _____
Date well completed _____ 19____
Application for plugging filed _____ 19____
Application for plugging approved _____ 19____
Plugging commenced 3-3-66 _____ 19____
Plugging completed 3-8-66 _____ 19____
Reason for abandonment of well or producing formation _____
Dry
If a producing well is abandoned, date of last production _____ 19____
Was permission obtained from the Conservation Division or its agents before plugging was commenced? Yes

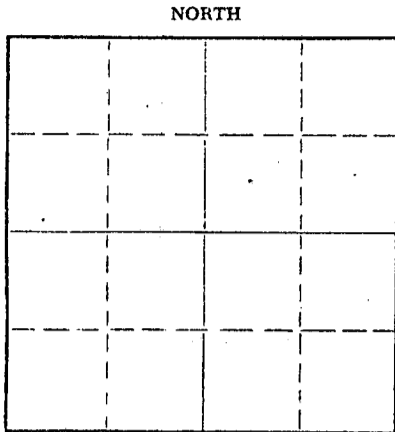

Locate well correctly on above Section Plat

Name of Conservation Agent who supervised plugging of this well W. L. Nichols
Producing formation _____ Depth to top _____ Bottom _____ Total Depth of Well PB 3590 Feet
Show depth and thickness of all water, oil and gas formations.

OIL, GAS OR WATER RECORDS

CASING RECORD

FORMATION	CONTENT	FROM	TO	SIZE	PUT IN	PULLED OUT
				8 5/8	155	None
				5 1/2	None	716

Describe in detail the manner in which the well was plugged, indicating where the mud fluid was placed and the method or methods used in introducing it into the hole. If cement or other plugs were used, state the character of same and depth placed, from _____ feet to _____ feet for each plug set.

Moved in. Rigged up. Cleaned out cellar. Sanded to 3540'. Dumped 5 sacks of cement. Working pipe.

Working pipe. Shot casing, shot no good.

Shot pipe at 700' - pipe started. Pulling pipe.

Squeezed well with 35 sacks of mud and 100 sacks of cement.

3/10/66
RECEIVED
STATE CORPORATION COMMISSION

MAR 10 1966

(If additional description is necessary, use BACK of this sheet)

Name of Plugging Contractor Forbes Casing Pulling, Inc.
Address P. O. Box 221 Great Bend, Kansas

STATE OF Kansas, COUNTY OF Barton, ss.
J. O. Forbes (employee of owner) or (owner or operator) of the above-described

well, being first duly sworn on oath, says: That I have knowledge of the facts, statements, and matters herein contained and the log of the above-described well as filed and that the same are true and correct. So help me God.

(Signature) J. O. Forbes
P. O. Box 221 Great Bend, Kansas
(Address)

SUBSCRIBED AND SWORN TO before me this 9 day of March, 1966

My commission expires May 27, 1969

Notary Public.

OPERATOR Fred Jones Mfg. Co.
 ADDRESS Oklahoma City, Oklahoma

FORMATION RECORD


Give detailed description and thickness of all formations drilled through, contents of sand, whether dry water, oil or gas.

Formation	Top	Bottom	Formation	Top	Bottom
Shale	0	146			
IAE Shale	146	300			
Shale, sand & Shells	300	1100			
Shale & Shells	1100	1460			
Shale & Shells	1460	1565			
Sand	1565	1705			
Shells, Red bed	1705	1750			
Shale, shells & Red bed	1750	1950			
Anhydrite	1950	1983			
Anhydrite	1983	1983			
Shale & shells	1983	2200			
Shale & lime	2200	3380			
Lime & Shale	3380	3450			
Shale & Lime	3450	3530			
Lime & Shale	3530	3590			
Lime	3590	3770			

TOPS:

Elevation 2320
 Anhydrite 1950
 Heopner 3523
 Lansing 3545
 T.D. 3770

FARM NAME Goff WELL NO. 3 COUNTY ITAHOMA TWP. 8 SEC. 3 ROE. 24

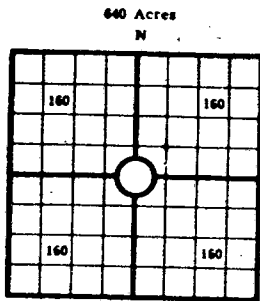

Locate well correctly

COUNTY Graham, SEC. 3 TWP. 8 ROE. 24
 COMPANY OPERATING Fred Jones Mfg. Co.
 OFFICE ADDRESS Oklahoma City, Okla.
 FARM NAME Goff WELL NO. 4
 DRILLING STARTED 2-9-55 DRILLING FINISHED 2-20-55
 DATE OF FIRST PRODUCTION _____ COMPLETED _____
 WELL LOCATED SE 1/4 NE 1/4 SW 1/4 North of South
 Line and _____ ft. East of West Line of Quarter Section
 Elevation (Relative to sea level) 2318 DERRICK FLOOR _____ GROUND _____
 CHARACTER OF WELL (Oil, gas or dryhole) Oil

OIL OR GAS SANDS OR ZONES

Name	From	To	Name	From	To
1			4		
2			5		
3			6		

Perforating Record If Any

Formation	From	To	No of Shots	Formation	From	To	Size of Shot

Shot Record

CASING RECORD

Amount Set								Amount Pulled				Packer Record	
Size	Wt	Thds	Make	Ft.	In	Ft.	In	Size	Length	Depth Set	Make		
3 1/2				2 1/2									
4 1/2				3 7/8									

Liner Record Amount _____ Kind _____ Top _____ Bottom _____

CEMENTING AND MUDDING

Size	Amount Set		Sacks Cement	Chemical		Method of Cementing	Amount	Mudding Method	Results (See Note)
	Ft.	In		Gal	Make				
3 1/2	146	14							
4 1/2	3770	7							

Note: What method was used to protect sands if outer strings were pulled? _____

NOTE: Were bottom hole plugs used? _____ If so, state kind, depth set and results obtained _____

TOOLS USED

Rotary Tools were used from _____ feet to _____ feet. Cable tools were used from _____ feet to _____ feet, and from _____ feet to _____ feet, and from _____ feet to _____ feet.

Type Rig _____

INITIAL PRODUCTION TEST

Describe initial test, whether by flow through tubing or casing or by pumping _____
 Amount of Oil Production _____ bbls. Size of choke, if any _____ Length of test _____ Water
 Production _____ bbls. Gravity of oil _____ Type of Pump if pump is used, describe _____

I, the undersigned, being first duly sworn upon oath, state that this well record is true, correct and complete according to the records of this office and to the best of my knowledge and belief.

Fred Jones I.C.C.-P.R.C.
 Name and title of representative of company

Subscribed and sworn to before me this 14th day of February, 1955
 My Commission expires Oct. 11, 1958 Lucille Gandy
 Notary Public