


STATE OF KANSAS  
STATE CORPORATION COMMISSION

WELL PLUGGING RECORD

Give All Information Completely  
Make Required Affidavit  
Mail or Deliver Report to:  
Conservation Division  
State Corporation Commission  
800 Bitting Building  
Wichita, Kansas

Graham County. Sec. 4 Twp. 8 Rge. 24 (E) W (W)

Location as "NE/CNW $\frac{1}{4}$ SW $\frac{1}{4}$ " or footage from lines SW NE SE  
Lease Owner Benson-Montin  
Lease Name Neal Well No. 2  
Office Address 1501 Republic Building, Oklahoma City, Oklahoma  
Character of Well (completed as Oil, Gas or Dry Hole) Dry Hole  
Date well completed February 19 1954  
Application for plugging filed February 19 1954  
Application for plugging approved February 19 1954  
Plugging commenced February 20 1954  
Plugging completed February 20 1954  
Reason for abandonment of well or producing formation Dry Hole

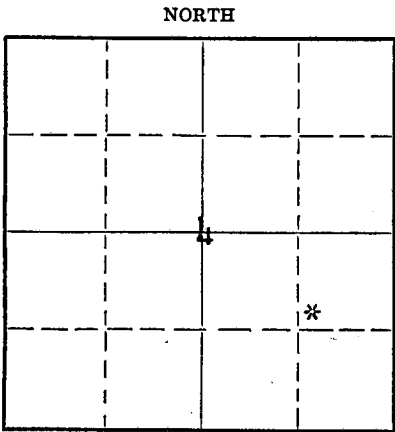

Locate well correctly on above Section Plat

If a producing well is abandoned, date of last production ---- 19  
Was permission obtained from the Conservation Division or its agents before plugging was commenced? Yes

Name of Conservation Agent who supervised plugging of this well Eldon Petty  
Producing formation Depth to top - Bottom - Total Depth of Well 3801 Feet  
Show depth and thickness of all water, oil and gas formations.

OIL, GAS OR WATER RECORDS

CASING RECORD

Formation	Content	From	To	Size	Put In	Pulled Out

Describe in detail the manner in which the well was plugged, indicating where the mud fluid was placed and the method or methods used in introducing it into the hole. If cement or other plugs were used, state the character of same and depth placed, from feet to feet for each plug set.

Spot 15 Sacks 3740' 15 Sacks 3720' through D.P. with service company  
Filled hole with heavy mud Bridged hole 150 ft. cemented with 15 sacks  
Bridged hole 40 ft. cemented with 10 sacks

RECEIVED  
STATE CORPORATION COMMISSION  
FEB 26 1954  
2-26-1954  
CONSERVATION DIVISION

(If additional description is necessary, use BACK of this sheet)

Correspondence regarding this well should be addressed to Benson-Montin  
Address 1501 Republic Building, Oklahoma City, Oklahoma

STATE OF KANSAS, COUNTY OF BARTON, ss.  
S. A. Berwick (employee of owner) or (owner or operator) of the above-described well,  
being first duly sworn on oath, says: That I have knowledge of the facts, statements, and matters herein contained and the log of the above-described well as filed and that the same are true and correct. So help me God.

(Signature) S. A. Berwick  
P. O. Box 64, Great Bend, Kansas  
(Address)

SUBSCRIBED AND SWORN TO before me this 22 day of February, 1954

John W. Dove  
Notary Public.

My commission expires April 11, 1955

PLUGGING  
FILE SEC 4 T 8 R 246  
BOOK PAGE 15 LINE 31

BIRMINGHAM  
1501 Republic Building  
Oklahoma City, Oklahoma

Neal No. 2

Total Depth: 3301' R.B.  
Commenced R. D.: 2-12-54  
Completed R. D.: 2-9-54

SW-NE-SE Sec. 4-8-24W  
Graham County, Kansas  
Elevation: 2322'  
Initial Prod.: Dry  
Contractor: S. A. Berwick  
Drilling Co.

Strata	Depth
Surface Soil and Shale	0- 153
Shale	153-1205
Sand	1205-1260
Shale and Shells	1260-1450
Shale	1450-1970
Anhydrite	1970-2000
Shale and Shells	2000-2750
Shale	2750-3060
Shale and Lime	3060-3301

I hereby certify the above a true and correct log of said well as reflected by the daily drilling report.

S. A. BERWICK DRILLING COMPANY

By S. A. Berwick Owner

Signed and sworn to in my presence this 22nd day of February, 1954, by  
S. A. Berwick, Owner of the S. A. Berwick Drilling Company.

John W. Poor  
Notary Public

My Commission Expires: April 11, 1955

2-26-1954

