


STATE OF KANSAS
STATE CORPORATION COMMISSION

WELL PLUGGING RECORD

Give All Information Completely
Make Required Affidavit
Mail or Deliver Report to:
Conservation Division
State Corporation Commission
800 Biting Building
Wichita, Kansas

NORTH

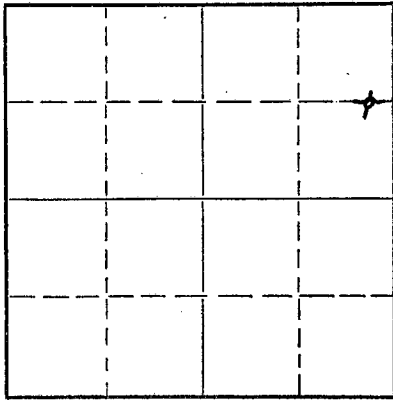

Locate well correctly on above
Section Plat

Graham County. Sec. 4 Twp. 8S Rge. 24 (E) W (W)
Location as "NE/CNWxSWx" or footage from lines C E/2 E/2 NE/4
Lease Owner The Derby Oil Company
Lease Name Neal Well No. 2
Office Address P.O. Box 1030, Wichita, Kansas
Character of Well (completed as Oil, Gas or Dry Hole) Dry Hole
Date well completed May 15 1954
Application for plugging filed May 15 1954
Application for plugging approved May 15 1954
Plugging commenced May 15 1954
Plugging completed May 15 1954
Reason for abandonment of well or producing formation Dry hole

If a producing well is abandoned, date of last production _____ 19____
Was permission obtained from the Conservation Division or its agents before plugging was commenced? Yes

Name of Conservation Agent who supervised plugging of this well Eldon Petty
Producing formation _____ Depth to top _____ Bottom _____ Total Depth of Well 3865 Feet
Show depth and thickness of all water, oil and gas formations.

OIL, GAS OR WATER RECORDS

CASING RECORD

FORMATION	CONTENT	FROM	TO	SIZE	PUT IN	PULLED OUT
		0	126	8 5/8	126	None

Describe in detail the manner in which the well was plugged, indicating where the mud fluid was placed and the method or methods used in introducing it into the hole. If cement or other plugs were used, state the character of same and depth placed, from _____ feet to _____ feet for each plug set.


3865' to 181½' - heavy rotary mud
 181½' to 180' - wooden plug
 180' to 134' - 15 sacks cement & ½ sack hulls
 134' to 41½' - heavy rotary mud
 41½' to 40' - wooden plug
 40' to 6' - 10 sacks cement & ½ sack hulls
 6' to surface - cellar

RECEIVED
 STATE CORPORATION COMMISSION
 MAY 21 1954
 CONSERVATION DIVISION
 WICHITA, KANSAS

(If additional description is necessary, use BACK of this sheet)
Name of Plugging Contractor Glenn W. Peel
Address P.O. Box 359, Hoisington, Kansas

STATE OF KANSAS, COUNTY OF BARTON, ss.
Glenn W. Peel (employee of owner) or (owner or operator) of the above-described well, being first duly sworn on oath, says: That I have knowledge of the facts, statements, and matters herein contained and the log of the above-described well as filed and that the same are true and correct. So help me God: GLENN W. PEEL

(Signature) BY: [Signature]
P.O. Box 359, Hoisington, Kansas
(Address)

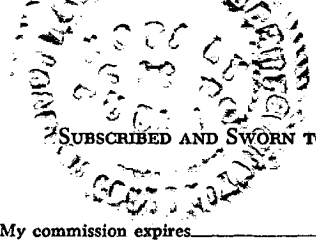

SUBSCRIBED AND SWORN TO before me this 17th day of May, 1954

My commission expires June 4, 1955 Notary Public.

PLUGGING
 FILED SEC. 4 T. 8 R. 24
 BOOK PAGE 34 LINE 35

DRILLERS' LOG

Company: The Derby Oil Company

C E/2 E/2 NE/4
Sec. 4, Twp. 8S, Rge. 24W,

Farm Name: Neal Well No. 2

County: Graham,
Kansas

Total Depth: 3865'

Comm: 5-6-54 Comp: 5-15-54
Contractor: Glenn W. Peel

Elevation:

Casing: 8 5/8" 126' cem.

Production: Dry

Figures below indicate bottoms of formations:

Surface soils and sands	0 -	126
Shale		1270
Shale and sand		2000
Shale		2025
Anhydrite		2055
Shale and shells		2625
Lime and shale		3500
Lime		3865
Total Depth		3865

This is to certify that the above information is to the best of our knowledge, true and correct.

GLENN W. PEEL

BY: Wm. Herbert

SUBSCRIBED AND SWORN to before me this 17th day of May, 1954.

My commission expires: June 4, 1955

Marion M. Holst
Notary Public

GEOLOGICAL TOPS

- HEEBNER 3593 - 1219
- TORONTO 3616 - 1242
- LANSING 3624 - 1250
- B.KC 3848 - 1574

5-21-1954

