


STATE OF KANSAS
STATE CORPORATION COMMISSION

Give All Information Completely
Make Required Affidavit
Mail or Deliver Report to:
Conservation Division
State Corporation Commission
211 No. Broadway
Wichita, Kansas

WELL PLUGGING RECORD

Graham County, Sec. 5 Twp. 8S Rge. 24W (E) (W)

Location as "NE/CNW&SW&" or footage from lines NW NW NE
Lease Owner Imperial Oil of Kansas, Inc.
Lease Name Goff Well No. 1
Office Address Wichita, Kansas
Character of Well (completed as Oil, Gas or Dry Hole) Dry Hole
Date well completed November 8, 19 57
Application for plugging filed November 8, 19 57
Application for plugging approved November 8, 19 57
Plugging commenced November 8, 19 57
Plugging completed November 8, 19 57
Reason for abandonment of well or producing formation No commercial quantities of oil found.

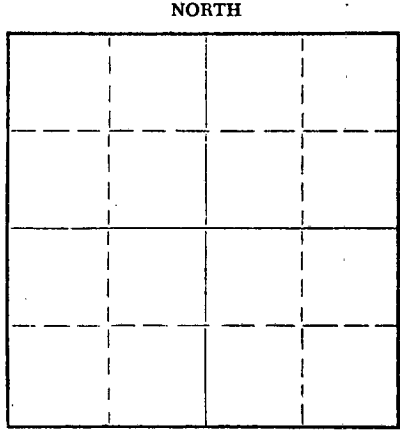

Locate well correctly on above Section Plat

If a producing well is abandoned, date of last production _____ 19____
Was permission obtained from the Conservation Division or its agents before plugging was commenced? yes

Name of Conservation Agent who supervised plugging of this well Eldon Petty, Hays, Kansas
Producing formation _____ Depth to top _____ Bottom _____ Total Depth of Well 3835 Feet
Show depth and thickness of all water, oil and gas formations.

OIL, GAS, OR WATER RECORDS

CASING RECORD

FORMATION	CONTENT	FROM	TO	SIZE	PUT IN	PULLED OUT
				8-5/8"	10-29-57	

Describe in detail the manner in which the well was plugged, indicating where the mud fluid was placed and the method or methods used in introducing it into the hole. If cement or other plugs were used, state the character of same and depth placed, from _____ feet to _____ feet for each plug set.

Set No. 1 plug at 500 feet with 25 sacks cement. Set No. 2 plug at 220 feet with 15 sacks cement. Set No. 3 plug at 30 feet with 10 sacks cement.

RECEIVED
STATE CORPORATION COMMISSION
NOV 20 1957
11-20-1957
CONSERVATION DIVISION
Wichita, Kansas


(If additional description is necessary, use BACK of this sheet)
Name of Plugging Contractor Imperial Oil of Kansas, Inc.
Address 780 Fourth National Bldg., Wichita 2, Kansas

STATE OF KANSAS COUNTY OF SEDGWICK, ss.
Raymond L. Bacon (employee of owner) or (owner or operator) of the above-described

well, being first duly sworn on oath, says: That I have knowledge of the facts, statements, and matters herein contained and the log of the above-described well as filed and that the same are true and correct. So help me God. IMPERIAL OIL OF KANSAS, INC.

(Signature) By: Raymond L. Bacon V-P
780 Fourth National Bldg., Wichita 2, Kansas (Address)

SUBSCRIBED AND SWORN TO before me this 19th day of November, 19 57

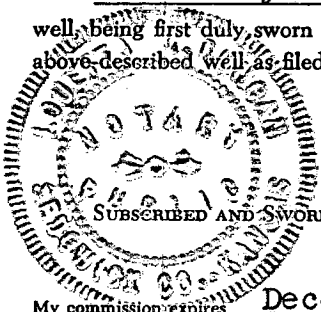

Louetta M. Duncan
Notary Public.

PLUGGING
FILE SEC S T 8 R 24W
BOOK PAGE 60 LI E 34

DRILLER'S LOG

Imperial Oil of Kansas, Inc.
780 Fourth National Bldg.
Wichita 2, Kansas

Goff No. 1
NW NW NE Sec. 5-8S-24W
Graham County, Kansas

Total Depth: 3835

Elevation: 2343' K.B.
Production: D & A

Commenced: 10-29-57 Completed: 11-8-57

Contractor: Imperial Oil of Kansas, Inc.
Wichita, Kansas

Casing Record: Set 8-5/8" Surface Pipe at 213' with 175 sacks cement.

Figures indicate bottom of formations:

Clay and Sand	40'		
Shale & Shells	213'		
Shale	950'		
Sand & Shale	1600'	Anhydrite	2025' (318)
Sand	1775'	Heebner	3583' (-1240)
Shale	2025'	Lansing	3620' (-1277)
Anhydrite	2055'	Rotary Total Depth	3835' (-1492)
Shale & Shells	2450'		
Shale & Lime	2730'		
Lime	3835'		
Total Depth	3835'		

We hereby certify this to be a correct and accurate log of the above described well as shown on the daily drilling reports.

IMPERIAL OIL OF KANSAS, INC.

By: Ray E. Bacon
Vice-President



Subscribed and sworn to before me this 19th day of November, 1957.

My Commission Expires:

RECEIVED
STATE CORPORATION COMMISSION

December 19, 1960

NOV 20 1957
11-20-1957
CONSERVATION DIVISION
Wichita, Kansas

Louetta M. Duncan
Notary Public

PLUGGING
FILE SEC. S T 8 R 24W
BOOK PAGE 60 LINE 34