


Give All Information Completely  
Make Required Affidavit  
Mail or Deliver Report to:  
Conservation Division  
State Corporation Commission  
800 Bitting Building  
Wichita, Kansas

WELL PLUGGING RECORD

NORTH

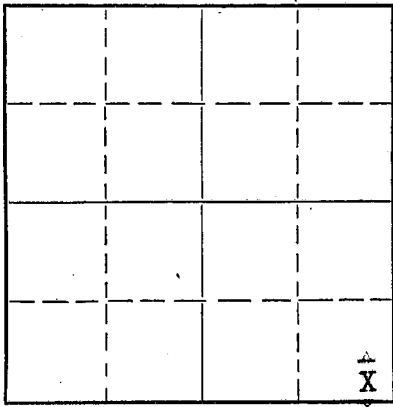

Locate well correctly on above  
Section Plat

Graham County, Sec. 7 Twp 8 Rge. 24 (E) W (W)  
Location as "NE/CNW $\frac{1}{4}$ SW $\frac{1}{4}$ " or footage from lines SE $\frac{1}{4}$  SE $\frac{1}{4}$  SE $\frac{1}{4}$   
Lease Owner Prime Drilling Company & Milo Siegel  
Lease Name Goddard # 1 Well No. 1  
Office Address Oklahoma City, Oklahoma  
Character of Well (completed as Oil, Gas or Dry Hole) Dry Hole  
Date well completed 2-7-1952  
Application for plugging filed 2-7-1952  
Application for plugging approved 2-7-1952  
Plugging commenced 2-7-1952  
Plugging completed 2-7-1952  
Reason for abandonment of well or producing formation

If a producing well is abandoned, date of last production 19  
Was permission obtained from the Conservation Division or its agents before plugging was commenced? Yes

Name of Conservation Agent who supervised plugging of this well Eldon Petty, Hays, Kansas  
Producing formation Depth to top Bottom Total Depth of Well 4475 Feet  
Show depth and thickness of all water, oil and gas formations.

OIL, GAS OR WATER RECORDS

CASING RECORD

| Formation | Content | From | To | Size  | Put In | Pulled Out |
|-----------|---------|------|----|-------|--------|------------|
|           |         |      |    | 8-5/8 | 255    | None       |
|           |         |      |    |       |        |            |
|           |         |      |    |       |        |            |
|           |         |      |    |       |        |            |
|           |         |      |    |       |        |            |

Describe in detail the manner in which the well was plugged, indicating where the mud fluid was placed and the method or methods used in introducing it into the hole. If cement or other plugs were used, state the character of same and depth placed, from feet to feet for each plug set.

Filled hole to 240 with heavy drilling mud, set plug and cemented with 16 sacks cement, filled hole to 40' with heavy drilling mud, set plug and cemented to bottom of cellar with 10 sacks cement.

RECEIVED  
STATE COMMISSION  
FEB 12 1952  
CONSERVATION DIVISION  
Wichita, Kansas

(If additional description is necessary, use BACK of this sheet)  
Name of Plugging Contractor Prime Drilling Company  
Address 1516 Apco Tower, Oklahoma City, Oklahoma

2-12-52

STATE OF Oklahoma, COUNTY OF Oklahoma, ss.  
L. J. Kruse (employee of owner) or (owner/operator) of the above-described well,

being first duly sworn on oath, says: That I have knowledge of the facts, statements, and matters herein contained and the log of the above-described well as filed and that the same are true and correct. So help me God.

(Signature) L. J. Kruse  
Oklahoma City, Oklahoma (Address)

SUBSCRIBED AND SWORN to before me this 11th day of February, 1952

Lillian Wright  
Notary Public.

My commission expires October 24, 1955

23-8390-s 6-51-20M

PLUGGING  
FILE SEC 7 T 8 R 240  
BOOK PAGE 143 LINE 17

15-065-00217-00-00

PRIME DRILLING COMPANY & MILO SIEGEL, ET AL

GODDARD # 1


SE/4 SE/4 SE/4 of  
Section 7-8S-24W  
Graham County, Kans.

| <u>Formations</u>     | <u>From</u> | <u>To</u> | <u>Remarks</u>  |
|-----------------------|-------------|-----------|---|
| Surface Rock & Clay   | 0           | 150       |   |
| Sand                  | 150         | 190       |   |
| Gray Shale            | 190         | 253       | 8-5/8" C.S.A. @ 253'. Cemented<br>with 150 Sacks Cement |
| Shale & Shells        | 253         | 530       |   |
| Chalk Rock & Shale    | 530         | 620       |   |
| Shale & Shell         | 620         | 1055      |   |
| Red Bed Shale & Sand  | 1055        | 1280      |   |
| Sand                  | 1280        | 1370      |   |
| Sand & Shale          | 1370        | 1440      |   |
| Shale Shells Red Bed  | 1440        | 1650      |   |
| Sand & Shale          | 1650        | 1850      |   |
| Shale Shells Red Bed  | 1850        | 1920      |   |
| Shale Shells Red Bed  | 1920        | 2085      |   |
| Anhydrite             | 2085        | 2115      |   |
| Red Bed & Shale       | 2115        | 2350      |   |
| Shale Red Bed & Lime  | 2350        | 2400      |   |
| Shale Shells Red Bed  | 2400        | 2620      |   |
| Red Bed Shale & Shell | 2620        | 2680      |   |
| Shale & Lime          | 2680        | 3325      |   |
| Lime & Shale          | 3325        | 3458      |   |
| Shale & Lime          | 3458        | 3500      |   |
| Lime & Shale          | 3500        | 3735      |   |
| Lime                  | 3735        | 3935      |   |
| Shale & Lime          | 3935        | 3980      |   |
| Lime & Shale          | 3980        | 4097      |   |
| Shale & Lime          | 4097        | 4230      |   |
| Shale & Chert         | 4230        | 4280      |   |
| Lime & Chert          | 4280        | 4475      |   |
| Total Depth           |             | 4475'     |   |

2-12-52

I hereby certify the foregoing to be a true and accurate Driller's Log  
of the formations encountered in the above well.

PRIME DRILLING COMPANY

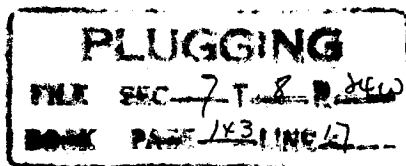

By: [Signature]  
L. J. Kruse  
Secretary

Subscribed and sworn to before me this 11th day of February, 1952.

My Commission Expires: 10-24-1955

[Signature]  
Notary Public