


WELL PLUGGING RECORD

Give All Information Completely
Make Required Affidavit
Mail or Deliver Report to:
Conservation Division
State Corporation Commission
211 No. Broadway
Wichita, Kansas

Graham County. Sec. 26 Twp. 8S Rge. 24 (E) W (W)
Location as "NE/CNW%SW%" or footage from lines NE SW SW
Lease Owner C-G Drilling Co., George Grenyo, et al.
Lease Name Arthur Kobler Well No. 1
Office Address 107 Rule Bldg.
Character of Well (completed as Oil, Gas or Dry Hole) dry hole
Date well completed June 23 19 65
Application for plugging filed June 23 19 65
Application for plugging approved June 23 19 65
Plugging commenced June 23 19 65
Plugging completed June 23 19 65
Reason for abandonment of well or producing formation too low structurally

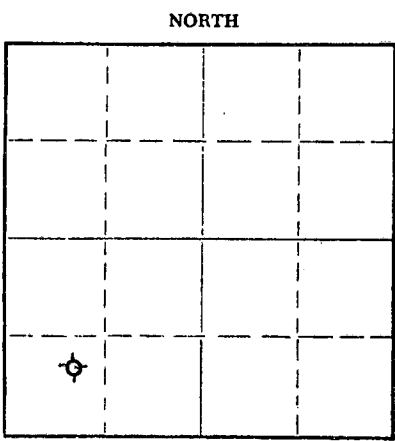

Locate well correctly on above Section Plat

If a producing well is abandoned, date of last production _____ 19____
Was permission obtained from the Conservation Division or its agents before plugging was commenced? yes

Name of Conservation Agent who supervised plugging of this well W L Nichols
Producing formation _____ Depth to top _____ Bottom _____ Total Depth of Well 3880 Feet
Show depth and thickness of all water, oil and gas formations.

OIL, GAS OR WATER RECORDS

CASING RECORD

FORMATION	CONTENT	FROM	TO	SIZE	PUT IN	PULLED OUT
				8-5/8"	206'	none

Describe in detail the manner in which the well was plugged, indicating where the mud fluid was placed and the method or methods used in introducing it into the hole. If cement or other plugs were used, state the character of same and depth placed, from _____ feet to _____ feet for each plug set.

Filled with heavy mud to 540'. set plug. Filled with heavy mud & 20 sx cement. Set plug @ 200'. Filled with heavy mud, 1/2 sx hulls, 20 sacks cement to 35'. Set plug. Filled with 1/2 sx hulls & 10 sacks cement to top.


RECEIVED
STATE CORPORATION COMMISSION
6-30-1965
JUN 30 1965

CONSERVATION DIVISION
WICHITA, KANSAS

(If additional description is necessary, use BACK of this sheet)
Name of Plugging Contractor C-G Drilling Co.
Address 107 Rule Bldg., Wichita, Kansas

STATE OF Kansas, COUNTY OF Sedgwick, ss.
G. F. Galloway (~~owner or operator~~) or (owner or operator) of the above-described well, being first duly sworn on oath, says: That I have knowledge of the facts, statements, and matters herein contained and the log of the above-described well as filed and that the same are true and correct. So help me God.

(Signature) C-G DRILLING CO., 107 Rule Bldg., Wichita
By G F Galloway (Address)

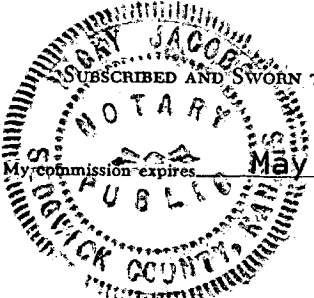

SUBSCRIBED AND SWORN to before me this 25th day of June 19 65
Vicky Jacobs
Notary Public.

W E L L L O G

OPERATOR: C-G DRILLING CO., GEORGE GRENYO, et al
 WELL NAME: ARTHUR KOBLER LOCATION: NE SW SW Sec. 26-8S-24W
 COUNTY: GRAHAM STATE: KANSAS
 WELL COMMENCED: 6/15/65 WELL COMPLETED: 6/23/65
 ELEVATION: 2335' K.B. TOTAL DEPTH: 3880'
 PRODUCTION: Dry & Abandoned RIG NO: 1
 CASING - 8-5/8": 6 JTS, SET AT 206', with 140 sx Quikset cement.
 5-1/2": _____

All Measurements taken from the top of rotary bushing.

FROM	TO	FORMATION	DEVIATION FROM VERTICAL	REMARKS:
0	206	Sand-Shale		
206	1380	shale-Sand	1000' - 3/4°	
1380	1575	Shale		
1575	1770	Sand		
1770	1955	Red Bed-Shale		
1955	2020	Red Bed-Shale		
2020	2060	Anhydrite		
2060	2145	Shale-Shells		
2145	2490	Shale		
2490	3065	Lime-Shale	2500' - 3/4°	
3065	3315	Shale-Lime	3000' - 3/4°	
3315	3435	Lime-Shale		
3435	3695	Lime-Shale		
3695	3750	Lime		#1 DST: 3703-3714
3750	3880	Lime		#2 DST: 3730-3750
				#3 DST: 3790-3828
				#4 DST: 3823-3880

RECEIVED
STATE CORPORATION COMMISSION

JUN 30 1965
 6-30-1965
 CONSERVATION DIVISION
 Wichita, Kansas

STATE OF KANSAS 0 SS:
 COUNTY OF SEDGWICK)

The undersigned hereby certifies that to the best of his knowledge and belief, the above facts are true and correct.

C-G DRILLING CO.

By *D. J. allwar*

SUBSCRIBED AND SWORN TO, BEFORE ME, This 24th day of June, 1965

Vicky Jacobs
 Vicky Jacobs - Notary Public

