

15-065-20919-00-00


STATE OF KANSAS
STATE CORPORATION COMMISSION

WELL PLUGGING RECORD

Give All Information Completely
Make Required Affidavit
Mail or Deliver Report to
Conservation Division
State Corporation Comm.
245 North Water
Wichita, KS 67202

Graham County, Sec. 34 Twp. 8 Rge. 24W E/W
Location as "NE/CNW $\frac{1}{4}$ SW $\frac{1}{4}$ " or footage from lines NE SW SE

Lease Owner Donald C. Slawson
Lease Name Bradley 'A' Well No. 1
Office Address 408 One Twenty Building, Wichita, Kansas
Character of Well (Completed as Oil, Gas or Dry Hole) dry hole
Date Well completed April 11, 1977 19
Application for plugging filed April 11 1977
Application for plugging approved April 11 1977
Plugging commenced April 11 1977
Plugging completed April 11 1977
Reason for abandonment of well or producing formation dry hole

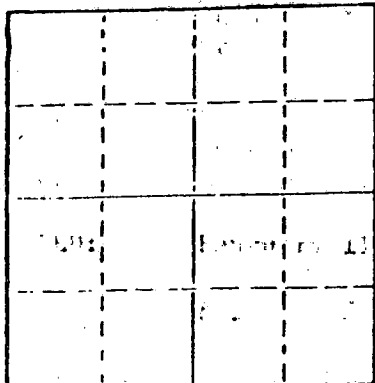

Locate well correctly on above Section Plat

If a producing well is abandoned, date of last production 19

Was permission obtained from the Conservation Division or its agents before plugging was commenced? yes

Name of Conservation Agent who supervised plugging of this well Gilbert Balthazor
Producing formation Depth to top Bottom Total Depth of Well 4010
Show depth and thickness of all water, oil and gas formations.

OIL, GAS OR WATER RECORDS

CASING RECORD

FORMATION	CONTENT	FROM	TO	SIZE	PUT IN	PULLED OUT
5/8" 290'	290'		296'	8 5/8"		

Describe in detail the manner in which the well was plugged, indicating where the mud fluid was placed and the method or methods used in introducing it into the hold. If cement or other plugs were used, state the character of same and depth placed, from _____ feet to _____ feet for each plug set.

bottom plug @ 900' w/70 sx
2nd plug @ 240' w/20' sx
bridge plug @ 40' w/10 sx
2 sx in rathole

RECEIVED
STATE CORPORATION COMMISSION

MAY 05 1977

CONSERVATION DIVISION
Wichita, Kansas

(If additional description is necessary, use BACK of this sheet)
Name of Plugging Contractor Slawson Drilling Company, Inc. 5-5-77

STATE OF Kansas COUNTY OF Sedgwick, ss.
R.J. Thatcher (employee of owner) or (owner or operator)
of the above-described well, being first duly sworn on oath, says: That I have knowledge of the facts, statements, and matters herein contained and the log of the above-described well as filed and that the same are true and correct. So help me God.

(Signature) R.J. Thatcher
408 One Twenty Building, Wichita, Kansas
(Address)

SUBSCRIBED AND SWORN TO before me this 2nd day of May, 1977

Margene Hamer
Notary Public.

My commission expires November 9, 1980



WELL LOG

15-065-20919-00-00

OPERATOR: Donald C. Slawson
 408 One Twenty Building
 Wichita, Kansas 67202

LEASE: #1 Bradley 'A'
 NE SW SE Sec. 34-8-24W
 Graham County, Kansas

CONTRACTOR: Slawson Drilling Company, Inc.

COMMENCED: February 5, 1977

COMPLETED: February 11, 1977

CASING: 8 5/8" @ 296' w/200 sx 60/40 poz

0 - 305	Surface hole
305 - 410	Sand and Shale
410 - 1737	Shale
1737 - 1860	Sand
1860 - 2106	Shale
2106 - 2164	Anhydrite
2164 - 2405	Shale
2405 - 2802	Shale and Lime
2802 - 3865	Lime
3865 - 4010	Lime and Shale
4010	RTD

RECEIVED
STATE CORPORATION COMMISSION


MAY 05 1977
5-5-77
CONSERVATION DIVISION
Wichita, Kansas

STATE OF KANSAS)
)
 COUNTY OF SEDGWICK) SS.

I, R.J. Thatcher, of the Slawson Drilling Company, Inc. upon oath state that the above and foregoing is a true and correct copy of the log of the #1 Bradley 'A' well.


 R.J. Thatcher

Subscribed and sworn to before me this 2nd day of May, 1977.

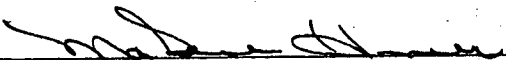
 MarGene Hamer, Notary Public

My Commission Expires: 11/9/80

