

13-065-20991-00-00


STATE OF KANSAS
STATE CORPORATION COMMISSION

WELL PLUGGING RECORD

Give All Information Completely
Make Required Affidavit
Mail or Deliver Report to
Conservation Division
State Corporation Comm.
245 North Water
Wichita, KS 67202

Graham County, Sec. 34 Twp. 8 Rge. 24 E/W
Location as "NE/CNW $\frac{1}{4}$ SW $\frac{1}{4}$ " or footage from lines
C W/2 SW SW/4

Lease Owner Barnett Oil, Inc.
Lease Name Brown #1 Well No. _____
Office Address Hill City, Kansas 67642
Character of Well (Completed as Oil, Gas or Dry Hole) _____

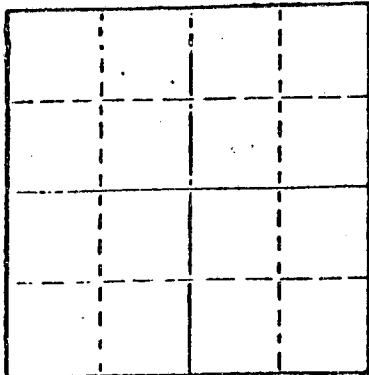

Locate well correctly on above
Section Plat

Date Well completed _____ 19____
Application for plugging filed _____ 19____
Application for plugging approved _____ 19____
Plugging commenced 5/22/79 _____ 19____
Plugging completed 5/25/79 _____ 19____
Reason for abandonment of well or producing formation
depleted.

If a producing well is abandoned, date of last production _____ 19____

Was permission obtained from the Conservation Division or
its agents before plugging was commenced? yes

Name of Conservation Agent who supervised plugging of this well Balthazor
Producing formation _____ Depth to top _____ Bottom _____ Total Depth of Well 4020
Show depth and thickness of all water, oil and gas formations.

OIL, GAS OR WATER RECORDS

CASING RECORD

FORMATION	CONTENT	FROM	TO	SIZE	PUT IN	PULLED OUT
				805/8	169	none
				4 $\frac{1}{2}$ "	4019	1659'

Describe in detail the manner in which the well was plugged, indicating where the mud fluid was placed and the method or methods used in introducing it into the hold. If cement or other plugs were used, state the character of same and depth placed, from _____ feet to _____ feet for each plug set.

Sanded to 3900' and ran 4 sacks cement. Loaded hole with salt water, shot pipe at 3300', 2220', 1900', 1670', pulled 51 joints. Allied pumped 3 sacks hulls, 70 sacks cement, 14 sacks gel, plug and 60 sacks cement.

PLUGGING COMPLETE.

RECEIVED
STATE CORPORATION COMMISSION

JUN - 4 1979

6-4-79

(If additional description is necessary, use BACK of this sheet)

Name of Plugging Contractor KELSO CASING PULLING
CHASE, KANSAS CONSERVATION DIVISION
Wichita, Kansas

STATE OF KANSAS COUNTY OF RICE, ss.
R. DARREEL KELSO (employee of owner) or (owner or operator)

of the above-described well, being first duly sworn on oath, says: That I have knowledge of the facts, statements, and matters herein contained and the log of the above-described well as filed and that the same are true and correct. So help me God.

(Signature) [Signature]
CHASE, KANSAS (Address)

SUBSCRIBED AND SWORN TO before me this 31st day of May, 19 79



[Signature]
Notary Public.

My commission expires _____

WELL LOG

15-065-209a1-00-00

COMPANY Barnett Oil, Inc.

SEC. 34 T. 8S. R. 24W
LOC. C W/2 SW SW/4

FARM BROWN NO. 1

RIG. NO. 16


TOTAL DEPTH 4020'

COUNTY Graham
KANSAS

COMM. 2-26-78

COMP. 3-4-78

CONTRACTOR Murfin Drilling Company

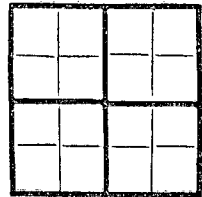

CASING

20 10
15 8-5/8" @ 169' w/140 sx.

ELEVATION

12 6
13 5

PRODUCTION

4 1/2" @ 4019' w/100 sx.
FIGURES INDICATE BOTTOM OF FORMATIONS

50'	Surface Soil & Clay
95'	Sand
130'	Clay
170'	Shale
1160'	Shale & Sand
1685'	Shale & Red Beds
1790'	Shale & Sand
2139'	Sand & Shald
2171'	Anhydrite
3572'	Shale
3930'	Shale & Lime
4020'	Lime RTD

RECEIVED
STATE CORPORATION COMMISSION

DEC - 8 1978

12-8-78
CONSERVATION DIVISION
Wichita, Kansas

State of KANSAS
County of SEDGWICK ss:

I, Wm. S. Shropshire of the Murfin Drilling Company

upon oath state that the above and foregoing is a true and correct copy of the log of the Brown #1 well.

Wm. S. Shropshire
Wm. S. Shropshire, Asst. Gen. Mgr.

Subscribed and sworn to before me this 24th day of March 19 78

My Commission Expires:

SANDRA KAY ELLY
NOTARY PUBLIC
Butler County, Kansas
My Appt. Exp. 6-5-80

Sandra Kay May
NOTARY PUBLIC
Sandra Kay May