

15-065-20877-00-00


STATE OF KANSAS
STATE CORPORATION COMMISSION

WELL PLUGGING RECORD

Give All Information Completely
Make Required Affidavit
Mail or Deliver Report to
Conservation Division
State Corporation Comm.
245 North Water
Wichita, KS 67202

Graham County, Sec. 36 Twp. 8 Rge. 24 E/W
Location as "NE/CNW $\frac{1}{4}$ SW $\frac{1}{4}$ " or footage from lines

NE/NW/NW
Lease Owner The Maurice L. Brown Company
Lease Name Schrader Well No. 1
Office Address Suite 200, Sutton Place Bldg., Wichita, Ks.
Character of Well (Completed as Oil, Gas or Dry Hole)

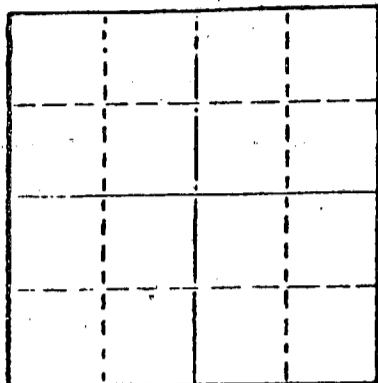

Locate well correctly on above Section Plat

Date Well completed 19
Application for plugging filed 19
Application for plugging approved 19
Plugging commenced November 18 19 77
Plugging completed November 21 19 77
Reason for abandonment of well or producing formation depleted

If a producing well is abandoned, date of last production 19

Was permission obtained from the Conservation Division or its agents before plugging was commenced? yes

Name of Conservation Agent who supervised plugging of this well Gilbert Balthazor
Producing formation Depth to top Bottom Total Depth of Well 4000'
Show depth and thickness of all water, oil and gas formations.

OIL, GAS OR WATER RECORDS

CASING RECORD

FORMATION	CONTENT	FROM	TO	SIZE	PUT IN	PULLED OUT
				8 5/8"	246'	none
				5 1/2"	3995'	694.77'

Describe in detail the manner in which the well was plugged, indicating where the mud fluid was placed and the method or methods used in introducing it into the hold. If cement or other plugs were used, state the character of same and depth placed, from feet to feet for each plug set.

Dumped sand to 3850' and 5 sacks cement.
Shot pipe at 1,000', 800' and 700'.
Pulled 17 joints of 5 1/2" casing.
Plugged well with 3 sacks hulls 70 sacks 50/50 pozmix cement,
9 sacks gel, and 60 sacks cement.

RECEIVED
STATE CORPORATION COMMISSION

NOV 28 1977

CONSERVATION DIVISION
Wichita, Kansas

11-28-77


(If additional description is necessary, use BACK of this sheet)

Name of Plugging Contractor Rockhold Engineering, Inc.
P. O. Box 698, Great Bend, Kansas 67530

STATE OF Kansas COUNTY OF Barton ss.
James W. Rockhold (employee of owner) or (owner or operator) of the above-described well, being first duly sworn on oath, says: That I have knowledge of the facts, statements, and matters herein contained and the log of the above-described well as filed and that the same are true and correct. So help me God.

(Signature) James W. Rockhold
Box 698, Great Bend, Kansas 67530 (Address)

Subscribed and sworn to before me this 23rd day of November 1977

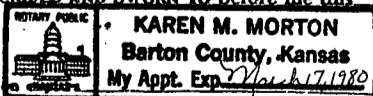

Notary Public. Karen M. Morton

DEC 28 1976

File

15-065-20877-00-00

CONTRACTOR'S WELL LOG

OPERATOR:
CONTRACTOR:
WELL NAME:
LOCATION:

The Maurice L. Brown Co.
Abercrombie Drilling, Inc.
SCHRADER #1
NE NW NW, Section 36-8S-24W
Graham County, Kansas
12-11-76
12-23-76

SPUD DATE:
COMPLETION DATE:

0	72	Surface Clay
72	110	Sand
110	1638	Shale
1638	1839	Sand
1839	2039	Shale
2089	2126	Anhydrite
2126	3065	Shale
3065	3640	Shale & Lime
3640	3790	Lime & Shale
3790	4000	Lime
	4000	Rotary Total Depth

Spud at 6:30 a.m. 12-11-76. Drilled 247' of 12 1/4" hole. Ran 6 jts. of 8 5/8" surface casing. (Tally 239') Set at 246' K.B. Cemented with 190 sx. of Class "A" Cement, 3% Ca. Cl. Cement did circulate. Job complete at 12:30 a.m. 12-12-76.

T. D. 4000', Ran 101 jts. of 5 1/2" - 15 1/2# Casing. (Tally Threads Off 3896.71') Set at 3995' K. E Cemented 1st stage with 150 sx. of 65/35 posmix with 2% gel and 10% salt, 3/4% CFR-2, 10# Gilsonite - 1/2# tough fiber per sack. Cemented 2nd stage with 375 sacks of HLC with 10# Gilsonit per sack. Plug was down at 1:40 a.m. 12-23-76.

SAMPLE TOPS:

Anhydrite 2089'
B/Anhydrite 2126'

RECEIVED
STATE CORPORATION COMMISSION

NOV 15 1977

CONSERVATION DIVISION
Wichita, Kansas

11-15-77

STATE OF KANSAS)
) SS
COUNTY OF SEDGWICK)

Jack L. Partridge, Assistant Secretary-Treasurer of Abercrombie Drilling, Inc., does hereby state that the above and foregoing is a true and correct log of the SCHRADER #1, NE NW NW, Section 36-8S-24W, Graham County, Kansas.

ABERCROMBIE DRILLING, INC.

BY: Jack L. Partridge
Jack L. Partridge, Asst. Sec. Treas.

COPY

Subscribed and sworn to before me, a Notary Public, in and for the aforesaid county and state as of this 27th day of December, 1976.

Kathy S. Goertz
Kathy S. Goertz, Notary Public

