

15-179-30000-00-00

Form CP-4

STATE OF KANSAS
STATE CORPORATION COMMISSION

WELL PLUGGING RECORD

Give All Information Completely
Make Required Affidavit
Mail or Deliver Report to:
Conservation Division
State Corporation Commission
211 No. Broadway
Wichita, Kansas

Sheridan County, Sec. 4 Twp. 9S Rge. 26 (E) W (W)

Location as "NE/CNW&SW&" or footage from lines C NW NW

Lease Owner Raymond Oil Company, Inc.

Lease Name Minium Well No. 1

Office Address 410 Fourth National Bank Building, Wichita, Kansas

Character of Well (completed as Oil, Gas or Dry Hole) Oil Well

Date well completed October 15 19 64

Application for plugging filed January 4 19 65

Application for plugging approved January 5 19 65


Plugging commenced Jan. 11 19 65

Plugging completed Feb 5 19 65

Reason for abandonment of well or producing formation No longer commercially productive

If a producing well is abandoned, date of last production December 27 19 64

Was permission obtained from the Conservation Division or its agents before plugging was commenced? Yes

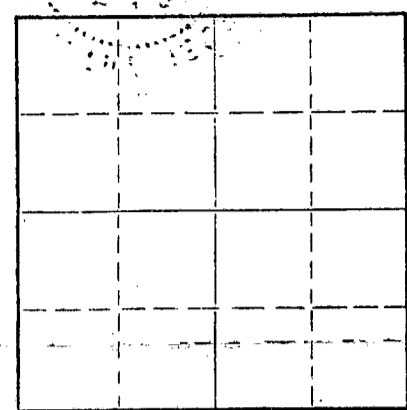

Locate well correctly on above Section Plat

Name of Conservation Agent who supervised plugging of this well W. L. Nichols

Producing formation _____ Depth to top _____ Bottom _____ Total Depth of Well 4010 Feet

Show depth and thickness of all water, oil and gas formations.

OIL, GAS OR WATER RECORDS

CASING RECORD

FORMATION	CONTENT	FROM	TO	SIZE	PUT IN	PULLED OUT
				8 5/8"	228'	
				5 1/2"	3983'	

Describe in detail the manner in which the well was plugged, indicating where the mud fluid was placed and the method or methods used in introducing it into the hole. If cement or other plugs were used, state the character of same and depth placed, from _____ feet to _____ feet for each plug set:

Filled back in the 5" with gravel. Dumped 5 sacks of cement. Shot pipe off at 2337'. Pulled pipe to 600'. Mixed jet mud and pumped it with Halliburton until it circulated. Pulled pipe to 500' and spotted 20 sacks of cement with Halliburton. Pulled pipe to 200' and spotted 20 sacks of cement with Halliburton. Pulled pipe to 35' and spotted 10 sacks of cement with Halliburton.

RECEIVED
STATE CORPORATION COMMISSION
FEB 10 1965
02-10-1965
CONSERVATION DIVISION
Wichita, Kansas

Name of Plugging Contractor Bert Self (If additional description is necessary, use BACK of this sheet)

Address Hutchinson, Kans.

STATE OF Kans. Employee, COUNTY OF Reno, ss.

(employee of owner) or (owner or operator) of the above-described well, being first duly sworn on oath, says: That I have knowledge of the facts, statements, and matters herein contained and the log of the above-described well as filed and that the same are true and correct. So help me God.

(Signature) Bert Self
R. R. #4, Hutchinson, Kans.
(Address)

Subscribed and sworn to before me this 9th day of February, 19 65

Notary Public. (Signature) Dorothy Self



K-2100

WELL LOG

15-179-30000-0000

COMPANY Raymond Oil Company

SEC. 4 T. 9S R. 26W

FARM Minium NO. 1

LOC. NW NW

RIG. NO. 16


TOTAL DEPTH 4010'

COUNTRY Sheridan Co., Ks.
KANSAS

COMM. 10-6-64 COMP. 10-16-64

SHOT OR TREATED
CONTRACTOR Murfin Drilling Company

ISSUED

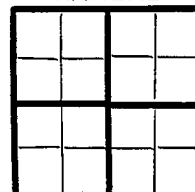

CASING

20 10
15 8 5/8" 228' w/200 sacks
12 6
13 5 1/2" 3983' w/150 sacks

ELEVATION

PRODUCTION Oil

FIGURES INDICATE BOTTOM OF FORMATIONS

- 230 Cement
- 1450 Shale
- 2182 Shale & Red Bed
- 2217 Anhydrite
- 2420 Shale
- 3155 Shale & Lime
- 3417 Lime & Shale
- 3500 Shale & Lime
- 3645 Lime & Shale
- 3700 Lime, Shale & Chalky Lime
- 3765 Shale & Lime
- 4010 Lime
- 4010 RTD

RECEIVED
STATE CORPORATION COMMISSION

JAN 5 1965
01-05-1965
CONSERVATION DIVISION
Wichita, Kansas

State of KANSAS
County of SEDGWICK } ss:

I, C. Robert Buford of the Murfin Drilling Company

upon oath state that the above and foregoing is a true and correct copy of the log of the Minium #1 well.

MURFIN DRILLING COMPANY

By: C. Robert Buford
C. Robert Buford

Subscribed and sworn to before me this 9th day of November 19 64

My Commission Expires: ADELA MIZENER, Notary Public
My commission expires November 5, 1966

Adela Mizener
NOTARY PUBLIC

