

15-179-20277-00-00

STATE OF KANSAS  
STATE CORPORATION COMMISSION

Form CP-4


Give All Information Completely  
Make Required Affidavit  
Mail or Deliver Report to:  
Conservation Division  
State Corporation Commission  
212 No. Market  
Wichita, Kansas 67202

WELL PLUGGING RECORD

Sheridan County, Sec. 5 Twp. 9S Rge. (E) 26 (W)

Location as "NE/CNWxSWx" or footage from lines SE SE NE  
Lease Owner Rosen Oil Corporation  
Lease Name Minium Well No. 1  
Office Address 200 Sutton Place, Wichita, Ks. 67202  
Character of Well (completed as Oil, Gas or Dry Hole) Dry Hole  
Date well completed February 9, 1971  
Application for plugging filed 19  
Application for plugging approved 19  
Plugging commenced February 9, 1971  
Plugging completed February 9, 1971  
Reason for abandonment of well or producing formation Dry Hole

NORTH

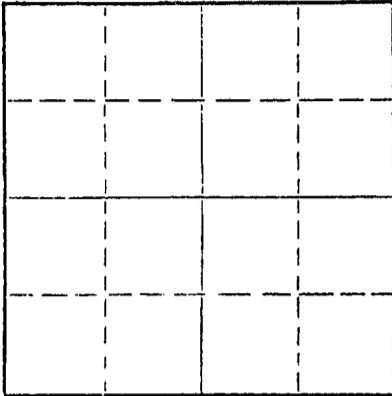

Locate well correctly on above  
Section Plat

If a producing well is abandoned, date of last production 19  
Was permission obtained from the Conservation Division or its agents before plugging was commenced? Yes (W. L. Nichols of Morland)

Name of Conservation Agent who supervised plugging of this well  
Producing formation Depth to top Bottom Total Depth of Well 3980 Feet  
Show depth and thickness of all water, oil and gas formations.

OIL, GAS OR WATER RECORDS

CASING RECORD

FORMATION	CONTENT	FROM	TO	SIZE	PUT IN	PULLED OUT
	Surface	0	237'	8-5/8"	237'	-----
	Casing					

Describe in detail the manner in which the well was plugged, indicating where the mud fluid was placed and the method or methods used in introducing it into the hole. If cement or other plugs were used, state the character of same and depth placed, from feet to feet for each plug set.

Heavy Mud from Total Depth to 1225 Feet,  
Plug and 100 sax cement; Mud to 245 Feet,  
Plug and 20 sax cement; Mud to 40 Feet,  
Plug bridged, 1/2 sax hulls and 10 sax  
cement to base of cellar; 2 sax cement  
in rat hole. Job completed @ 7 A.M.

RECEIVED  
STATE CORPORATION COMMISSION  
FEB 12 1971  
CONSERVATION DIVISION  
Wichita, Kansas  
02-12-1971


(If additional description is necessary, use BACK of this sheet)  
Name of Plugging Contractor Sun Oil Well Cementing, Inc.  
Address Box 169, Great Bend, Kansas

STATE OF KANSAS, COUNTY OF SEDGWICK, ss.  
Clarence Michael of Sage Drilling Co. (employee of owner) or (owner or operator) of the above described

well, being first duly sworn on oath, says: That I have knowledge of the facts, statements, and matters herein contained and the log of the above described well as filed and that the same are true and correct. So help me God.

(Signature) Clarence Michael  
500 Bitting Bldg., Wichita, Kansas  
(Address)

SUBSCRIBED AND SWORN to before me this 11th day of February, 1971

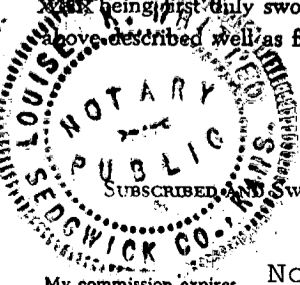

Louise K. Whitted  
Notary Public.

My commission expires November 26, 1971

15-179-20277-00-00

DRILLERS LOG

MINIUM NO. 1

CASING RECORD:	OPERATOR: Rosen Oil Corporation	DESCRIPTION:
8-5/8" @ 237' w/175 sax cement	CONTRACTOR: Sage Drilling Co.	SE SE NE Sec. 5-9S-26W Sheridan Co., Kans.
TOTAL DEPTH: 3980'	COMMENCED: February 1, 1971	ELEVATION: 2597KB
	COMPLETED: February 9, 1971	

<u>FORMATION</u>	<u>FROM</u>	<u>TO</u>	<u>REMARKS</u>
Shale & Shells	0	1190	
Shale	1190	1795	
Dakota Sand	1795	1980	
Shale & Red Bed	1980	2184	
Anhydrite	2184	2228	
Shale	2228	2485	
Lime & Shale	2485	3535	
Shale & Lime	3535	3695	
Lime & Shale	3695	3770	
Lime	3770	3887	
Lime & Shale	3887	3980	D&A

RECEIVED  
STATE CORPORATION COMMISSION  
FEB 12 1971  
CONSERVATION DIVISION  
Wichita, Kansas  
02-12-1971

I certify that this is a true and correct copy of the above log to the best of my knowledge.

SAGE DRILLING CO., INC.

By Clarence Michael  
Clarence Michael



Subscribed and sworn to before me this 11th day of February, 1971.

Louise K. Whitted  
Louise K. Whitted, Notary Public

My commission expires:  
November 26, 1974.