


15-179-30167-00-00

WELL PLUGGING RECORD

Give All Information Completely
Make Required Affidavit
Mail or Deliver Report to:
Conservation Division
State Corporation Commission
800 Bitting Building
Wichita, Kansas

NORTH

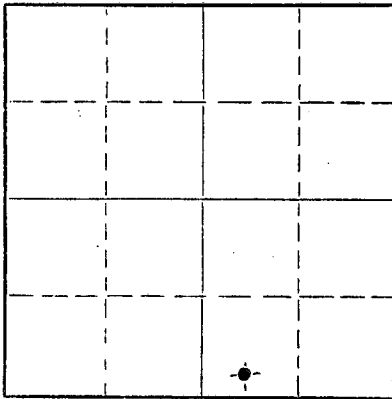

Locate well correctly on above
Section Plat

Sheridan County. Sec. 8 Twp. 9 Rge. (E) 26 (W)
Location as "NE/CNWxSWx" or footage from lines. C. S/2 SW SE
Lease Owner Graham-Messman-Rinehart Oil Company
Lease Name Shatzell Well No. 1
Office Address 1005 E. Second St., Wichita, Kansas
Character of Well (completed as Oil, Gas or Dry Hole) Dry hole
Date well completed January 9, 19 53
Application for plugging filed January 9, 19 53
Application for plugging approved January 12, 19 53
Plugging commenced January 9, 19 53
Plugging completed January 9, 19 53
Reason for abandonment of well or producing formation Dry hole

If a producing well is abandoned, date of last production _____ 19____
Was permission obtained from the Conservation Division or its agents before plugging was commenced? yes

Name of Conservation Agent who supervised plugging of this well Eldon Petty, Box 326, Hays, Kansas
Producing formation _____ Depth to top _____ Bottom _____ Total Depth of Well 4045 Feet
Show depth and thickness of all water, oil and gas formations.

OIL, GAS OR WATER RECORDS

CASING RECORD

FORMATION	CONTENT	FROM	TO	SIZE	PUT IN	PULLED OUT
				8 5/8"	300'	none

Describe in detail the manner in which the well was plugged, indicating where the mud fluid was placed and the method or methods used in introducing it into the hole. If cement or other plugs were used, state the character of same and depth placed, from _____ feet to _____ feet for each plug set.

Filled hole to 280', first
plug @ 280', 1/2 sack of hulls,
15 sx. cement. Filled hole to
35', second plug @ 35', 1/2 sack
hulls, 10 sx. cement.
Mud to surface.

RECORDED
JAN 27 1953
CONS. DIV. 15-179-30167-00-00
Wichita, Kansas

(If additional description is necessary, use BACK of this sheet)
Name of Plugging Contractor Graham-Messman-Rinehart Oil Company
Address P. O. Box 1033, Wichita, Kansas

STATE OF Kansas COUNTY OF Sedgwick, ss.
J. A. Gilliland (employee of owner) or ~~representative~~ of the above-described well, being first duly sworn on oath, says: That I have knowledge of the facts, statements, and matters herein contained and the log of the above-described well as filed and that the same are true and correct. So help me God.

(Signature) J. A. Gilliland
P. O. Box 1033, Wichita, Kansas
(Address)

SUBSCRIBED AND SWORN TO before me this 26th day of January, 19 53

December 1, 1956

Barbara J. Scott
Notary Public.



PLUGGING
FILE SEC ET 9 R 162
BOOK PAGE 71 LINE 42

15-179 - 30167-00-00

SHATZELL #1

WELL RECORD

Description:	C. S/2 SW SE 8-9-26W Sheridan County, Kansas.	Commenced:	December 30, 1952
Operator:	G-M-R Oil Company	Completed:	January 9, 1953
Contractor:	G-M-R Oil Company	Elevation:	2680 K.B.
Casing Record:	8 5/8" @ 300' w/165 sx.	Production:	D. & A.

LOG

Shale & Clay	230
Blue Shale	300
Shale & Sand	1340
Lime & Shale	1740
Shale	1745
Anhydrite	1785
Shale & Shells	2180
Brown Lime	2300
Lime & Shale	2515
Lime & Shale	2600
Shale & Lime	2780
Lime & Shale	2850
Lime & Shale	3005
Brown Lime	3116
Lime & Shale	3210
Lime & Shale	3285
Brown Lime	3375
Lime & Shale	3450
Lime & Shale	3513
Brown Lime	3613
Lime & Shale	3711
Lime & Shale	3795
Lime	3830
Lime	3856
Lime	3885
Lime	3945
Lime & Shale	3980
Lime	4021
Lime	4043 T.D.

01-27-1953

TOPS

Heebner	3781 (-1101)
Toronto	3802 (-1122)
Lansing	3822 (-1142)

The undersigned, GRAHAM-MESSMAN-RINEHART OIL COMPANY, hereby certifies that the above log is a true and correct log of the formation encountered in drilling the above well as reflected by the Daily Drilling Reports.

GRAHAM-MESSMAN-RINEHART OIL COMPANY

By *J. H. Heland*

Subscribed and sworn to before me this 22nd day of January, 1952.

Barbara J. Scott

My commission expires: December 1, 1956

