15-179-05640-00-00

STATE OF KANSAS
STATE CORPORATION COMMISSION

Give All Information Completely
Make Required Affidavit
Mail or Deliver Report to:
Conservation Division
State Corporation Commission
800 Bitting Building
Wichita, Kansas

WELL PLUGGING RECORD
OR
FORMATION PLUGGING RECORD

Strike out upper line when reporting plugging off formations.

NORTH

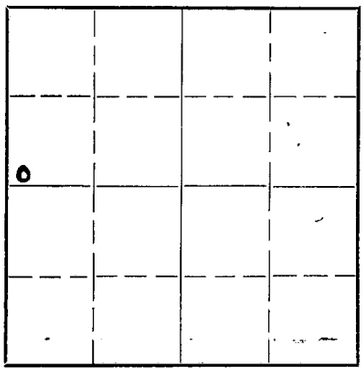

Locate well correctly on above Section Plat

Sheridan County. Sec. 16 Twp. 9S Rge. 26W (E) (W)

Location as "NE¼NW¼SW¼" or footage from lines SW¼ SW¼ NW¼

Lease Owner: Continental Oil Co.

Lease Name: Epler Well No. 1

Office Address: Ponca City, Oklahoma

Character of Well (completed as Oil, Gas or Dry Hole): Stratigraphic Test

Date well completed: Dec. 14, 1943

Application for plugging filed: Dec. 15, 1943

Application for plugging approved: Dec. 15, 1943

Plugging commenced: Dec. 15, 1943

Plugging completed: Dec. 20, 1943

Reason for abandonment of well or producing formation:

If a producing well is abandoned, date of last production: 19

Was permission obtained from the Conservation Division or its agents before plugging was commenced? Yes

Name of Conservation Agent who supervised plugging of this well: C. T. Alexander

Producing formation: Depth to top: Bottom: Total Depth of Well: Feet

Show depth and thickness of all water, oil and gas formations.

OIL, GAS OR WATER RECORDS — CASING RECORD

Formation	Content	From	To	Size	Put In	Pulled Out
				8 5/8"	275 ft.	None

Describe in detail the manner in which the well was plugged, indicating where the mud fluid was placed and the method or methods used in introducing it into the hold. If cement or other plugs were used, state the character of same and depth placed, from feet to feet for each plug set.

The hole was filled with heavy mud and a plug set at 275 feet was cemented with 15 sacks of cement which was put in thru the drill pipe. The hole was then filled with mud to 26 feet where another plug was set and the hole filled to the top with cement.

PLUGGING
FILE NO. 16 9 R 26W
BOOK PAGE 162 LINE 39

(If additional description is necessary, use BACK of this sheet)

Correspondence regarding this well should be addressed to: J. George Klein

Address: Box 448 Hill City, Kansas

STATE OF Kansas, COUNTY OF Graham, ss.

J. George Klein (employee of owner) or (owner or operator) of the above-described well, being first duly sworn on oath, says: That I have knowledge of the facts, statements, and matters herein contained and the log of the above-described well as filed and that the same are true and correct. So help me God.

(Signature) J. George Klein

Hill City, Kansas
(Address)

SUBSCRIBED AND SWORN TO before me this 23 day of December, 1943

Thos. Estabrook
Notary Public.

My commission expires March 1st-1947

19-6929 4-43—6M