


WELL PLUGGING RECORD

Give All Information Completely  
Make Required Affidavit  
Mail or Deliver Report to:  
Conservation Division  
State Corporation Commission  
212 No. Market  
Wichita, Kansas

Sheridan County, Sec. 19 Twp. 9 Rge. 26 (E) W. (W)

Location as "NE/CNW/SW" or footage from lines C-E/2-NE/4  
Lease Owner L. J. Dreiling & Sons, Inc.  
Lease Name Minium Well No. 1  
Office Address Route 2, Victoria, Kansas 67671  
Character of Well (completed as Oil, Gas or Dry Hole) Dry Hole  
Date well completed 5-21-1967  
Application for plugging filed 5-21-1967  
Application for plugging approved 5-21-1967  
Plugging commenced 5-21-1967  
Plugging completed 5-21-1967  
Reason for abandonment of well or producing formation Dry Hole

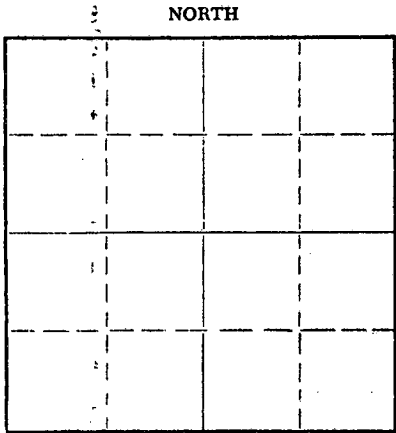

Locate well correctly on above Section Plat

If a producing well is abandoned, date of last production 19  
Was permission obtained from the Conservation Division or its agents before plugging was commenced? Yes

Name of Conservation Agent who supervised plugging of this well Bill Nichols  
Producing formation \_\_\_\_\_ Depth to top \_\_\_\_\_ Bottom \_\_\_\_\_ Total Depth of Well \_\_\_\_\_ Feet  
Show depth and thickness of all water, oil and gas formations.

OIL, GAS OR WATER RECORDS

CASING RECORD

FORMATION	CONTENT	FROM	TO	SIZE	PUT IN	PULLED OUT
SURFACE PIPE				8 5/8"	179'	

Describe in detail the manner in which the well was plugged, indicating where the mud fluid was placed and the method or methods used in introducing it into the hole. If cement or other plugs were used, state the character of same and depth placed, from \_\_\_\_\_ feet to \_\_\_\_\_ feet for each plug set.

Filled hole with rotary mud to a depth of 540' where 1st. plug was set using 20 sacks cement. Filling hole with rotary mud to a depth of 180' where 2nd. plug was set using 20 sacks cement. Rotary mud was used to fill hole to a depth of 40' where 3rd. plug was set using 10 sacks cement and filling hole to surface.

RECEIVED  
STATE CORPORATION COMMISSION  
MAY 26 1967  
CONSERVATION DIVISION  
Wichita, Kansas  
05-26-1967

(If additional description is necessary, use BACK of this sheet)

Name of Plugging Contractor L. J. Dreiling & Sons, Inc.  
Address Route 2, Victoria, Kansas 67671


STATE OF KANSAS, COUNTY OF ELLIS, ss.  
I, Leo F. Dreiling (employee of owner) or (owner/operator) of the above-described well, being first duly sworn on oath, says: That I have knowledge of the facts, statements, and matters herein contained and the log of the above-described well as filed and that the same are true and correct. So help me God.

(Signature) Leo F. Dreiling  
LEO F. DREILING, ROUTE 2, VICTORIA, KANSAS  
(Address)

SUBSCRIBED AND SWORN TO before me this 21st day of May, 19 67

My Commission expires September 19, 1970

Joseph A. Hess  
Joseph A. Hess Notary Public.

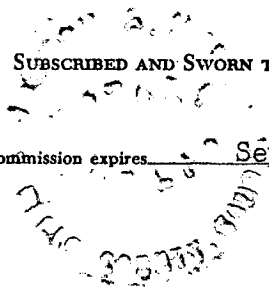

L. J. DREILING and SONS, Inc.

VICTORIA, KANSAS

WELL LOG

<b>Company</b>	L. J. Dreiling & Sons, Inc. Victoria, Kansas	<b>Sec.</b>	19	<b>Twp.</b>	9	<b>Rng.</b>	26
<b>Farm</b>	Minium No. 1	<b>Location</b>	C-E/2-NE/4				
<b>Total Depth</b>	4000'	<b>County</b>	Sheridan				
<b>Comm.</b>	5-15-67	<b>Comp.</b>	5-21-67				
<b>Contractor</b>	L. J. Dreiling & Sons, Inc. Victoria, Kansas	<b>Elevation:</b>	2645'	K.B.			
	<b>Casing Record</b>	<b>Cement Record</b>	2642'	D. F.			
	179' 8 5/8"	150 sacks cement	2640'	G. R.			
			<b>Production:</b>	D & A			

Figures Indicate Bottom of Formations

0'	40'	Surface Soil & Clay
40'	179'	Sand & Shale
179'	747'	Shale & Shells
747'	1715'	Shale
1715'	1763'	Gyp & Shale
1763'	2216'	Shale & Redbed
2216'	2257'	Anhy.
2257'	2400'	Shale & Shells
2400'	2670'	Shale & Lime
2670'	2980'	Lime & Shale
2980'	3239'	Lime & Shale
3239'	3345'	Shale & Lime
3345'	3570'	Lime & Shale
3570'	3715'	Lime & Shale
3715'	3793'	Lime & Shale
3793'	3800'	Lime
3800'	3840'	Lime
3840'	3880'	Lime & Shale
3880'	3945'	Lime & Shale
3945'	3950'	Lime & Shale
3950'	4000'	Lime
4000'	T.D.	

RECEIVED  
 STATE CONSERVATION COMMISSION  
 MAY 26 1967  
 05-26-1967  
 CONSERVATION DIVISION  
 Topeka, Kansas

STATE OF KANSAS)  
 )ss  
 COUNTY OF ELLIS)

I, Leo F. Dreiling, of the L. J. Dreiling & Sons, Inc., upon oath states that the above and foregoing is a true and correct copy from the Daily Drilling Report from the Minium #1.

*Leo F. Dreiling*  
 LEO F. DREILING

Subscribed and sworn to before me this 24th day of May 1967.

*Joseph A. Hess*  
 JOSEPH A. HESS NOTARY PUBLIC

My commission expires: September 19, 1970