

STATE OF KANSAS
STATE CORPORATION COMMISSION

WELL PLUGGING RECORD

Give All Information Completely
Make Required Affidavit
Mail or Deliver Report to
Conservation Division
State Corporation Comm.
245 North Water
Wichita, KS 67202

Sheridan County. Sec. 19 Twp. 9S Rge. 26 E/W
Location as "NE/CNW 1/4 SW 1/4" or footage from lines
C SW SE

Lease Owner The Maurice L. Brown Co.

Lease Name FRIEND Well No. 1

Office Address 1500 Vickers KSB&T Bldg, Wichita, Kansas 67202

Character of Well (Completed as Oil, Gas or Dry Hole)
Dry Hole

Date Well completed October 25 1976

Application for plugging filed (verbally) October 25 1976

Application for plugging approved (verbally) October 25 1976

Plugging commenced October 25 1976

Plugging completed October 25 1976

Reason for abandonment of well or producing formation
No commercial quantity of oil or gas encountered


If a producing well is abandoned, date of last production
19

Was permission obtained from the Conservation Division or
its agents before plugging was commenced? Yes

Name of Conservation Agent who supervised plugging of this well Gilbert Balthazor

Producing formation Depth to top Bottom Total Depth of Well

Show depth and thickness of all water, oil and gas formations.

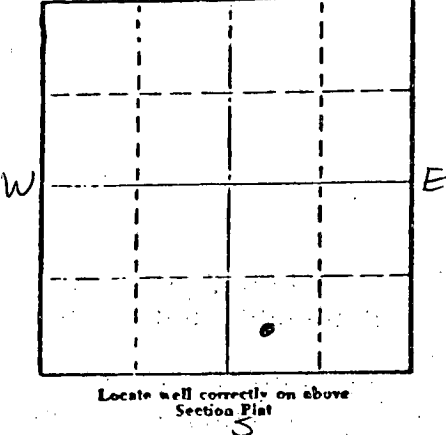

OIL, GAS OR WATER RECORDS

CASING RECORD

FORMATION	CONTENT	FROM	TO	SIZE	PUT IN	PULLED OUT

Describe in detail the manner in which the well was plugged, indicating where the mud fluid was placed and the method or methods used in introducing it into the hold. If cement or other plugs were used, state the character of same and depth placed, from feet to feet for each plug set.

1st plug was set at 1100' with 70 sx.
2nd plug was set at 250' with 20 sx.
40' bridge with 10 sx. - 50/50 posmix, 6% gel

Plug was down at 11:40 a.m. 10-25-76
State Plugger - Gilbert Balthazor

RECEIVED
STATE CORPORATION COMMISSION
NOV 03 1976
11-03-1976
CONSERVATION DIVISION
Wichita, Kansas

(If additional description is necessary, use BACK of this sheet)

Name of Plugging Contractor Abercrombie Drilling, Inc.

STATE OF Kansas COUNTY OF Sedgwick ss.

Jack L. Partridge, Asst. Sec.-Treas. (employee of owner) or (owner or operator) of the above-described well, being first duly sworn on oath, says: That I have knowledge of the facts, statements, and matters herein contained and the log of the above-described well as filed and that the same are true and correct. So help me God.

(Signature) Jack L. Partridge
801 Union Center, Wichita, Kansas 67202
(Address)

SUBSCRIBED AND SWORN TO before me this 29th day of October 1976

My commission expires

Kathy S. Goertz
Kathy S. Goertz Notary Public.



15-179-20440-00-00

CONTRACTOR'S WELL LOG

OPERATOR:	The Maurice L. Brown Co.
CONTRACTOR:	Abercrombie Drilling, Inc.
WELL NAME:	FRIEND #1
LOCATION:	C SW SE, Section 9-9S-26W Sheridan County, Kansas
SPUD DATE:	October 14, 1976
COMPLETION DATE:	October 25, 1976

0	135	Surface Clay
135	200	Sand
200	1113	Shale
1113	1671	Shale & Sand
1671	2241	Shale
2241	2276	Anhydrite
2276	2773	Shale
2773	2993	Shale & Lime
2993	3121	Shale
3121	3603	Shale & Lime
3603	3735	Lime & Shale
3735	4065	Lime
	4065	Rotary Total Depth

Spud hole at 3:00 p.m. 10-14-76. Cut 250' of 12 1/4" hole. Ran 6 jts. of 8 5/8" casing, (Tally 242') Set at 249' K.B. with 190 sx. Class "A" Cement, 3% Ca. Cl. Cement did circulate. Plug was down at 9:00 p.m. 10-14-76

T.D. 4065'. Set 1st plug at 1100' with 70 sx., set 2nd plug at 250' with 20 sx., 40' bridge with 10 sx. - 50/50 posmix, 6% gel. Plug was down at 11:40 a.m. - 10-25-76. State Plugger Gilbert Balthazor.

SAMPLE TOPS:

Anhydrite 2241'
B/Anhydrite 2276'

RECEIVED
STATE CORPORATION COMMISSION
NOV 03 1976

STATE OF KANSAS)
) SS
COUNTY OF SEDGWICK)

CONSERVATION DIVISION
Wichita, Kansas
11-03-1976

Jack L. Partridge, Assistant Secretary-Treasurer of Abercrombie Drilling, Inc., does hereby state that the above and foregoing is a true and correct copy of the log of the FRIEND #1, C SW SE, Section 9-9S-26W, Sheridan County, Kansas.

ABERCROMBIE DRILLING, INC.

BY: Jack L. Partridge
Jack L. Partridge, Asst. Sec.-Treas.

Subscribed and sworn to before me, a Notary Public, in and for the aforesaid county and state as of this 29th day of October, 1976.

Kathy S. Goertz
Kathy S. Goertz, Notary Public

