

15-179-20520-00-00

STATE OF KANSAS
STATE CORPORATION COMMISSION

WELL PLUGGING RECORD

Give All Information Completely
Make Required Affidavit
Mail or Deliver Report to
Conservation Division
State Corporation Comm.
245 North Water
Wichita, KS 67202

Sheridan County, Sec. 19 Twp. 9S Rge. 26WE/W
Location as "NE/CNW $\frac{1}{4}$ SW $\frac{1}{4}$ " or footage from lines
NW NE NE

Lease Owner The Maurice L. Brown Company
Lease Name Minium Well No. 1

Office Address 200 Sutton Place, Wichita, Kansas
Character of Well (Completed as Oil, Gas or Dry Hole)


Dry Hole

Date Well completed Oct. 18 1978
Application for plugging filed (verbally) Oct. 18 1978
Application for plugging approved (verbally) Oct. 18 1978
Plugging commenced Oct. 18 1978
Plugging completed Oct. 18 1978

Reason for abandonment of well or producing formation
No commercial quantity of oil or gas encountered
If a producing well is abandoned, date of last production 19

Was permission obtained from the Conservation Division or its agents before plugging was commenced? Yes

Name of Conservation Agent who supervised plugging of this well Gilbert Balthazor
Producing formation Depth to top Bottom Total Depth of Well 4060'
Show depth and thickness of all water, oil and gas formations.

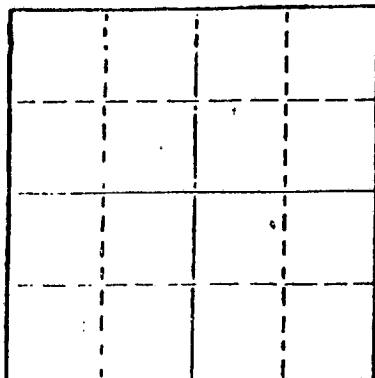

Locate well correctly on above Section Plat

OIL, GAS OR WATER RECORDS


CASING RECORD

FORMATION	CONTENT	FROM	TO	SIZE	PUT IN	PULLED OUT

Describe in detail the manner in which the well was plugged, indicating where the mud fluid was placed and the method or methods used in introducing it into the hold. If cement or other plugs were used, state the character of same and depth placed, from feet to feet for each plug set.

T.D. 4060'
Set 1st plug at 1100' with 70 sacks
2nd plug at 240' with 20 sacks
3rd plug at 40' solid bridge
rathole with 2 sacks

Cemented with 50/50 posmix, 6% gel.
Job was complete at 3:06 p.m., 10-18-78.
State Plugger - Gilbert Balthazor.

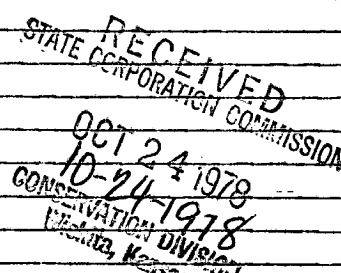


(If additional description is necessary, use BACK of this sheet)

Name of Plugging Contractor Abercrombie Drilling, Inc.

STATE OF Kansas COUNTY OF Sedgwick, ss.
Jack L. Partridge, Asst. Sec.-Treas. (employee of owner) or (owner or operator)
of the above-described well, being first duly sworn on oath, says: That I have knowledge of the facts, statements, and matters herein contained and the log of the above-described well as filed and that the same are true and correct. So help me God.

(Signature) Jack L. Partridge
801 Union Center, Wichita, Kansas 67202
(Address)

SUBSCRIBED AND SWORN TO before me this 20th day of October, 1978

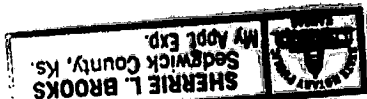

Sherrie L. Brooks
Notary Public.

My commission expires August 21, 1982

CONTRACTOR'S WELL LOG

OPERATOR: The Maurice L. Brown Company
 CONTRACTOR: Abercrombie Drilling, Inc.
 WELL NAME: Minium #1
 LOCATION: NW NE NE, Section 19-9S-26W
 Sheridan County, Kansas
 SPUD DATE: October 7, 1978
 COMPLETION DATE: October 18, 1978

0	251	Surface sand & clay
251	1700	Shale & Sand
1700	2230	Sand & Shale
2230	2245	Shale
2245	2278	Anhydrite
2278	2670	Shale
2670	2869	Lime & Shale
2869	3073	Shale & Lime
3073	3732	Lime & Shale
3732	3839	Lime
3839	3910	Lime & Shale
3910	3935	Lime
3935	3977	Lime & Shale
3977	4060	Lime
	4060	Rotary Total Depth

RECEIVED
 STATE CORPORATION COMMISSION
 OCT 24 1978
 10-24-1978
 CONSERVATION DIVISION
 Wichita, Kansas

Spud hole at 6:30 p.m., October 7, 1978. Drilled 251' of 12 1/4" hole. Ran 6 joints of 8 5/8" surface casing. Set at 249.56' with 190 sacks of common cement, 3% Ca.Cl., 2% gel. Cement did circulate. Plug was down at 11:45 p.m., October 7, 1978.

T.D. 4060'. Set 1st plug at 1100' with 70 sacks, 2nd plug at 240' with 20 sacks, 3rd plug at 40' solid bridge with 10 sacks, rathole with 2 sacks. Cemented with 50/50 posmix, 6% gel. Plug was down at 3:06 p.m., October 18, 1978.

SAMPLE TOPS:

Anhydrite 2245'


STATE OF KANSAS)
) ss
 COUNTY OF SEDGWICK)

Jack L. Partridge, Assistant Secretary-Treasurer of Abercrombie Drilling Inc., does hereby state that the above and foregoing is a true and correct copy of the log of the Minium #1, NW NE NE, Section 19-9S-26W, Sheridan County, Kansas.

ABERCROMBIE DRILLING, INC.

BY Jack L. Partridge
 Jack L. Partridge
 Assistant Secretary-Treasurer

Subscribed and sworn to before me, a Notary Public, in and for the county and state aforesaid, as of this 20th day of October, 1978.

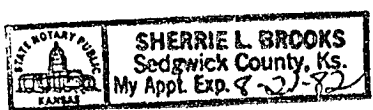

Sherrie L. Brooks
 Sherrie Brooks, Notary Public

My commission expires 8-21-82.