

15-069-20102-00-00


STATE OF KANSAS
STATE CORPORATION COMMISSION

Form CP-4

Give All Information Completely
Make Required Affidavit
Mail or Deliver Report to:
Conservation Division
State Corporation Commission
212 No. Market
Wichita, Kansas

WELL PLUGGING RECORD

NORTH

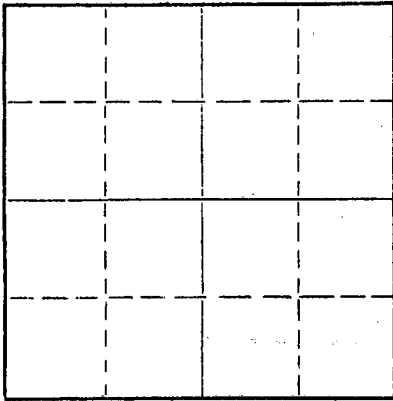

Locate well correctly on above
Section Plat

Graham County, Sec. 33 Twp. 8S Rge. 25W ~~26E~~ (W)
Location as "NE/CNW/SW" or footage from lines NE NE SW
Lease Owner Herman Geo. Kaiser, Oil Producer
Lease Name St. John Well No. B-#1
Office Address 909 Palace Bldg., Tulsa, Okla.
Character of Well (completed as Oil, Gas or Dry Hole) Dry Hole
Date well completed 12-2-67 19__
Application for plugging filed 12-2-67 19__
Application for plugging approved 12-2-67 19__
Plugging commenced 12-2-67 19__
Plugging completed 12-2-67 19__
Reason for abandonment of well or producing formation Dry Hole

If a producing well is abandoned, date of last production 19__
Was permission obtained from the Conservation Division or its agents before plugging was commenced? yes

Name of Conservation Agent who supervised plugging of this well Leo Massey
Producing formation _____ Depth to top _____ Bottom _____ Total Depth of Well 3770 Feet
Show depth and thickness of all water, oil and gas formations.

OIL, GAS OR WATER RECORDS

CASING RECORD

FORMATION	CONTENT	FROM	TO	SIZE	PUT IN	PULLED OUT
	START	CONSERVATION DIVISION	CONSERVATION DIVISION	8 5/8"	210'	none
		DEC 8 1967				
		CONSERVATION DIVISION				
		Wichita, Kansas				

Describe in detail the manner in which the well was plugged, indicating where the mud fluid was placed and the method or methods used in introducing it into the hole. If cement or other plugs were used, state the character of same and depth placed, from _____ feet to _____ feet for each plug set.

Plugged hole with 100 sks. cement @ 1200'
20 sks. cement @ 210', bridged plug @ 40' & cemented to bottom of cellar

(If additional description is necessary, use BACK of this sheet)

Name of Plugging Contractor Leben Drilling, Inc.
Address Box 486, Great Bend, Kansas 67530

STATE OF KANSAS, COUNTY OF BARTON, ss.

Leslie Kite's (employee of owner) or (owner or operator) of the above-described well, being first duly sworn on oath, says: That I have knowledge of the facts, statements, and matters herein contained and the log of the above-described well as filed and that the same are true and correct. So help me God.

(Signature) Leslie Kite
Box 486, Great Bend, Kansas 67530
(Address)

SUBSCRIBED AND SWORN TO before me this 7th day of December, 19 67

My commission expires April 1, 1971

Amanda Nichols
Notary Public.

DRILLER'S LOG

COMPANY: Herman Geo. Kaiser, Oil Producer
 CONTRACTOR: LEBEN DRILLING, INC.
 FARM: ST. JOHN B-#1
 LOCATION: NE NE SW SECTION 33-8S-25W
 GRAHAM COUNTY, KANSAS
 COMMENCED: 11-27-67
 COMPLETED: 12-2-67

0	40	Sand, Clay
40	210	Sand, Shale
210	1175	Shale
1175	1720	Shale, Sand
1720	1825	Redbed
1825	2210	Redbed, Shale
2210	2250	Anhydrite
2250	2875	Shale, Lime
2875	3337	Lime, Shale
3337	3670	Shale, Lime
3670	3770	Lime, Shale
	<u>3770</u>	<u>RTD - D. & A.</u>

RECEIVED
 STATE CONSERVATION COMMISSION
 DEC 8 1967
 12-8-67
 CONSERVATION DIVISION
 Wichita, Kansas

8 5/8" 17#, 2 jts. 28# new & used surface casing set @ 210' cemented with 150 sacks Common, 2% cc

I, Leslie Kite, do hereby certify that the above and foregoing is a true and correct copy of the log of the St. John B-#1 Well, located NE NE SW of Section 33, Township 8 South, Range 25 West, Graham County, Kansas, as reflected by the records of Leben Drilling, Inc.

Leslie Kite
 Leslie Kite

STATE OF KANSAS)
) SS
 COUNTY OF BARTON)

Subscribed and sworn to and before me, a Notary Public, in and for Barton County, Kansas, this 7th day of December, 1967.

Ulanda Nichols
 Ulanda Nichols



My Commission Expires:
 April 15, 1971