


WELL PLUGGING RECORD

Give All Information Completely
Make Required Affidavit
Mail or Deliver Report to:
Conservation Division
State Corporation Commission
800 Bitting Building
Wichita, Kansas

Graham County, Sec. 34 Twp. 8S Rge. 25 (E) W (W)

Location as "NE/CNW $\frac{1}{4}$ SW $\frac{1}{4}$ " or footage from lines NW NW NE
Lease Owner Peel-Hardman Oil Producers
Lease Name Setchell Well No. 1
Office Address P. O. Box 359, Hoisington, Kansas
Character of Well (completed as Oil, Gas or Dry Hole) Dry Hole
Date well completed August 26 19 52
Application for plugging filed August 26 19 52
Application for plugging approved August 26 19 52
Plugging commenced August 26 19 52
Plugging completed August 26 19 52
Reason for abandonment of well or producing formation Dry Hole

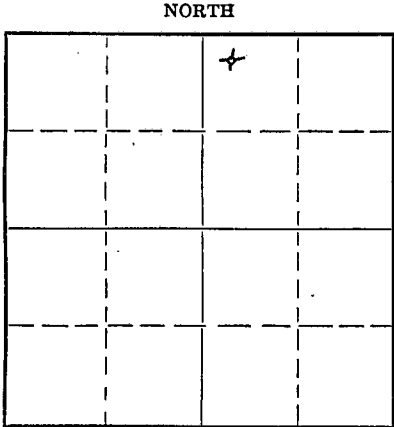

Locate well correctly on above Section Plat

If a producing well is abandoned, date of last production 19...
Was permission obtained from the Conservation Division or its agents before plugging was commenced? Yes

Name of Conservation Agent who supervised plugging of this well Eldon R. Petty
Producing formation Depth to top Bottom Total Depth of Well Feet
Show depth and thickness of all water, oil and gas formations.


OIL, GAS OR WATER RECORDS

CASING RECORD

Formation	Content	From	To	Size	Put In	Pulled Out
		0	240'	8 5/8"	240'	None

Describe in detail the manner in which the well was plugged, indicating where the mud fluid was placed and the method or methods used in introducing it into the hole. If cement or other plugs were used, state the character of same and depth placed, from feet to feet for each plug set.

4530' - 2311 $\frac{1}{2}$ ' - Heavy Rotary Mud
2311 $\frac{1}{2}$ ' - 2310' - Wooden Plug
2310' - 2264' - 15 sacks cement
2264' - 41 $\frac{1}{2}$ ' - Heavy Rotary Mud
41 $\frac{1}{2}$ ' - 40' - Wooden Plug
40' - 6' - 10 sacks cement
6- Surface & Cellar

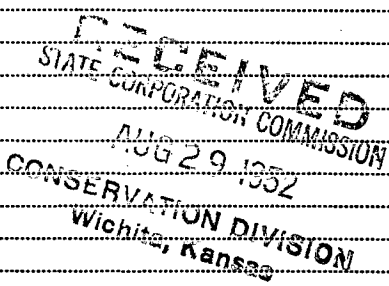

(If additional description is necessary, use BACK of this sheet)
Name of Plugging Contractor Glenn W. Peel
Address P. O. Box 359, Hoisington, Kansas

STATE OF Kansas, COUNTY OF Barton, ss.
Glenn W. Peel (employee of owner) or (owner or operator) of the above-described well,
being first duly sworn on oath, says: That I have knowledge of the facts, statements, and matters herein contained and the log of the above-described well as filed and that the same are true and correct. So help me God.

(Signature) BY: *Glenn W. Peel*
P. O. Box 359
Hoisington, Kansas (Address)

SUBSCRIBED AND SWORN to before me this 28th day of August, 19 52
Marion M. Hubert
Notary Public.

My commission expires June 4/1955

PLUGGING
FILE SEC 34 T 8 R 25
BOOK PAGE 40 LINE 29

15-065-00365-00-00

DRILLER'S LOG

Company: Peel-Hardman Oil Producers

Farm: Setchell Well No. 1
Total Depth: 4530'

Comm: 8-13-52 Comp: 8-26-52
Contractor: Glenn W. Peel
Casing: 8 5/8" 240' cem.

NW NW NE
Sec. 34, Twp. 8S, Rge. 25W.

County: Graham,
Kansas

Elevation:

Production: Dry

Figures below indicate bottom of formations

Surface Clay	0 -	40
Sand		70
Sand & Shale		160
Shale		240
Shale & Sand		1750
Red Bed		1920
Shale		2150
Anhydrite		2180
Shale		2355
Shale & Shells		2595
Shale		2740
Shale & Lime		3830
Lime		4530
Total Depth		4530

This is to certify that the above information is, to the best of our knowledge, true and correct.

GLENN W. PEEL

BY: Glenn W. Peel

SUBSCRIBED AND SWORN to before me this 28th day of August, 1952.

My commission expires June 4, 1955 Marion M. Herbert
Notary Public



PLUGGING
FILE SEC 34 T 8 R 25
BOOK PAGE 40 LINE 29

RECEIVED
STATE CORPORATION COMMISSION
AUG 29 1952
CONSERVATION DIVISION
Wichita, Kansas
829-52