


Give All Information Completely  
Make Required Affidavit  
Mail or Deliver Report to:  
Conservation Division  
State Corporation Commission  
212 No. Market  
Wichita, Kansas

WELL PLUGGING RECORD

Graham County. Sec. 35 Twp. 8 Rge. 25 (E) W (W)  
Location as "NE/CNW%SW%" or footage from lines SE SE SE  
Lease Owner Empire Drilling Co.  
Lease Name Richmier Well No. 1-B  
Office Address Wichita, Kansas  
Character of Well (completed as Oil, Gas or Dry Hole) Oil Well  
Date well completed May 17 1961  
Application for plugging filed June 16 1966  
Application for plugging approved June 16 1966  
Plugging commenced July 15 1966  
Plugging completed July 18 1966  
Reason for abandonment of well or producing formation Lack of oil

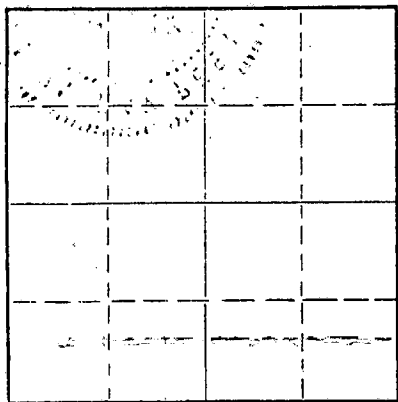

Locate well correctly on above Section Plat

If a producing well is abandoned, date of last production December 22 1966  
Was permission obtained from the Conservation Division or its agents before plugging was commenced? Yes

Name of Conservation Agent who supervised plugging of this well Nichols  
Producing formation Lansing Kansas City Depth to top \_\_\_\_\_ Bottom \_\_\_\_\_ Total Depth of Well 3971 Feet  
Show depth and thickness of all water, oil and gas formations.

OIL, GAS OR WATER RECORDS

CASING RECORD

FORMATION	CONTENT	FROM	TO	SIZE	PUT IN	PULLED OUT
	Shale-Sand	0	192	8 5/8"	175'	-0-
				5 1/2"	4049'	-0-

Describe in detail the manner in which the well was plugged, indicating where the mud fluid was placed and the method or methods used in introducing it into the hole. If cement or other plugs were used, state the character of same and depth placed, from 3971 feet to surface feet for each plug set.

Sanded up to 3765' dump 4 sacks of cement on bottom.  
Pulled pipe, Pump 30 sacks of mud & 80 sacks of cement in hole.  
Well completed.

RECEIVED  
STATE CORPORATION COMMISSION

AUG 16 1966

CONSERVATION DIVISION  
WICHITA, KANSAS

8-16-66

(If additional description is necessary, use BACK of this sheet)

Name of Plugging Contractor Barnes & Sons Pipe Pulling Co.  
Address P.O. Box 313 Russell, Kansas


STATE OF Kansas, COUNTY OF Sedgwick, ss.

Dan J. Kornfeld (owner or operator) of the above-described well, being first duly sworn on oath, says: That I have knowledge of the facts, statements, and matters herein contained and the log of the above-described well as filed and that the same are true and correct. So help me God.

(Signature) Dan J. Kornfeld  
650 4th Natl. Bank Bldg. Wichita, Kansas 67202  
(Address)

SUBSCRIBED AND SWORN to before me this 15th day of August, 1966

My commission expires September 14, 1968  
Sandra Kay Peer Notary Public.

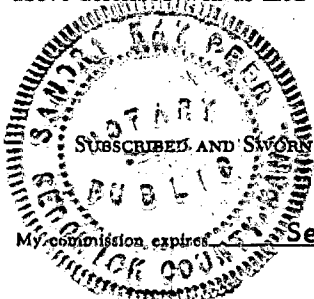

15-065-03330-00-00

RECEIVED  
CONSERVATION COMMISSION

JUN 16 1966

6-16-66

CONSERVATION DIVISION  
Wichita, Kansas

COMPANY

EMPIRE DRILLING COMPANY

CONTRACTOR

EMPIRE DRILLING COMPANY

FARM

RICHMEIER 'B' # 1

LOCATION

SE SE SE 35-8-25W  
GRAHAM COUNTY, KANSAS

COMMENCED \*\* MAY 7, 1961

ELEVATION 2514 KB

COMPLETED \*\* MAY 17, 1961

\*\*\*\*\*

0	TO	192	SHALE SAND
192	TO	710	SHALE
710	TO	1940	SHALE SHELLS
1940	TO	2205	SHALE SAND
2205	TO	<del>2205</del> 2240	ANHYDRITE
2240	TO	2585	SHALE SHELLS
2585	TO	2690	BROKEN SHALE
2690	TO	2990	SHALE LIME
2990	TO	3105	BROKEN LIME
3105	TO 3360	3360	LIME
3360	TO	3800	LIME SHALE
3800	TO	3813	LIME
3813	TO	3825	LIME CHERT
3825	TO	3831	LIME
3831	TO	3980	LIME SHALE
3880	TO	3890	LIME
3890	TO	3950	LIME/WHALE STREAKS
3950	TO	4035	LIME
4035	TO	4050	BROKEN LIME
4050			ROTARY TOTAL DEPTH

SET; 8 5/8" AT 175' WITH 160 SACKS CEMENT  
5 1/2" AT 4049' WITH 100 SACKS CEMENT