


STATE OF KANSAS
STATE CORPORATION COMMISSION

WELL PLUGGING RECORD

Give All Information Completely
Make Required Affidavit
Mail or Deliver Report to
Conservation Division
State Corporation Comm.
245 North Water
Wichita, KS 67202

Graham County. Sec. 36 Twp. 8 Rge. 25 E/W
Location as "NE/CNW $\frac{1}{4}$ /SW $\frac{1}{4}$ " or footage from lines
SW SW NE

Lease Owner Edmisbnn Oil Co.
Lease Name Hunsinger #1 Well No. _____
Office Address Great Bend, Kansas 67530
Character of Well (Completed as Oil, Gas or Dry Hole) _____

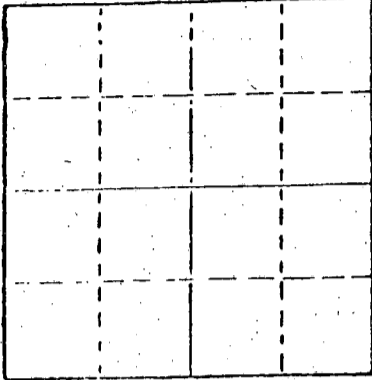

Date Well completed _____ 19____
Application for plugging filed _____ 19____
Application for plugging approved _____ 19____
Plugging commenced 3/11/80 _____ 19____
Plugging completed 3/17/80 _____ 19____
Reason for abandonment of well or producing formation depleted.

If a producing well is abandoned, date of last production _____ 19____

Was permission obtained from the Conservation Division or its agents before plugging was commenced? _____ yes

Name of Conservation Agent who supervised plugging of this well Balthazor
Producing formation _____ Depth to top _____ Bottom _____ Total Depth of Well 4052
Show depth and thickness of all water, oil and gas formations.

OIL, GAS OR WATER RECORDS

CASING RECORD

FORMATION	CONTENT	FROM	TO	SIZE	PUT IN	PULLED OUT
				8-5/8	569	none
				4 1/2"	4051	2830'

Describe in detail the manner in which the well was plugged, indicating where the mud fluid was placed and the method or methods used in introducing it into the hold. If cement or other plugs were used, state the character of same and depth placed, from _____ feet to _____ feet for each plug set.

Sanded to 3450' and ran 4 sacks cement. Loaded hole, shot pipe at 3397', 2985', 2820', pulled 68 joints. Pumped 3 sacks hulls, 70 sacks cement, 7 sacks gel, 8-5/8 plug and 60 sacks cement.

PLUGGING COMPLETE.

(If additional description is necessary, use BACK of this record)

Name of Plugging Contractor KELSO CASING PULLING
CHASE, KANSAS

RECEIVED
STATE CORPORATION COMMISSION
3-20-1980
MAR 20 1980
Wichita, Kansas

STATE OF KANSAS COUNTY OF RICE
R. DARRELL KELSO (employee of owner, lessee or operator)
of the above-described well, being first duly sworn on oath, says: That I have knowledge of the facts, statements, and matters herein contained and the log of the above-described well as filed and that the same are true and correct. So help me God.

(Signature) R. Darrell Kelso
CHASE, KANSAS (Address)

SUBSCRIBED AND SWORN TO before me this 19th day of March, 1980

My commission expires _____



Margaret Melcher
Notary Public.

JUL 6 1979

320-6

CONTRACTOR'S WELL LOG

OPERATOR: RAM Petroleum Corporation
 CONTRACTOR: Abercrombie Drilling, Inc.
 WELL NAME: Hunsicker #1
 LOCATION: SW SW NE, Section 36-8-25
 Graham County, Kansas
 SPUD DATE: June 20, 1979
 COMPLETION DATE: June 28, 1979

0	575	Sand and shale
575	875	Shale
875	1994	Shale and sand
1994	2180	Anhydrite
2180	3090	Shale
3090	3509	Lime and shale
3509	3715	Shale and lime
3715	3905	Lime and shale
3905	4023	Lime
4023	4035	Lime and shale
4035	4050	Lime
	4050	Rotary Total Depth

Spud hole at 5:30 p.m., June 20, 1979. Drilled 575' of 12 1/4" hole. Ran 14 joints of 8-5/8" - 20# casing. Set at 574' with 300 sacks, 150 sacks of 60/40 posmix, 3% Ca.Cl., 2% gel. followed with 150 sacks of common cement, 3% Ca.Cl., 2% gel. Cement did circulate. Plug was down at 1:45 a.m., June 21, 1979.

T.D. 4050'. Ran 98 joints of new 4 1/2" - 9 1/2# casing. Set at 4047' with 50 sacks of 60/40 posmix, salt saturated, 10 bbls. salt flush. Plug was down at 2:00 p.m., June 28, 1979.

SAMPLE TOPS:

Anhydrite 2180'
 B/Anhydrite 2218'

RECEIVED
 STATE CORPORATION COMMISSION

DEC - 6 1979
 12-6-1979
 CONSERVATION DIVISION
 Wichita, Kansas


STATE OF KANSAS)
)
 COUNTY OF SEDGWICK)

Jerry A. Langrehr, Executive Vice-President of Abercrombie Drilling, Inc., does hereby state that the above and foregoing is a true and correct copy of the log of the Hunsicker #1, SW SW NE, Section 36-8-25, Graham County, Kansas.

ABERCROMBIE DRILLING, INC.

BY: Jerry A. Langrehr
 Jerry A. Langrehr
 Executive Vice-President

Subscribed and sworn to before me, a Notary Public, in and for the county and state aforesaid, as of this 3rd day of July, 1979.

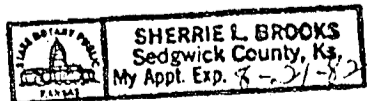

Sherrie L. Brooks
 Sherrie Brooks, Notary Public

My commission expires 8-21-82.