

WELL PLUGGING RECORD

Give All Information Completely
The Required Affidavit
Either Deliver Report to:
Conservation Division
State Corporation Commission
211 No. Broadway
Wichita, Kansas

Sheridan County. Sec. 2 Twp. 8S Rge. 26W (E) (W)

Location as "NE/CNW/SW" or footage from lines NE NE SW

Lease Owner D & D Drilling Company, Inc.

Lease Name Andregg No. Well No. 1

Office Address 308 Schweiter Building, Wichita, Kansas

Character of Well (completed as Oil, Gas or Dry Hole) Dry Hole

Date well completed 7-12-63 19

Application for plugging filed 7-19-63 19

Application for plugging approved 7-12-63 19


Plugging commenced 7-12-63 19

Plugging completed 7-12-63 19

Reason for abandonment of well or producing formation Dry Hole

If a producing well is abandoned, date of last production 19

Was permission obtained from the Conservation Division or its agents before plugging was commenced? Yes

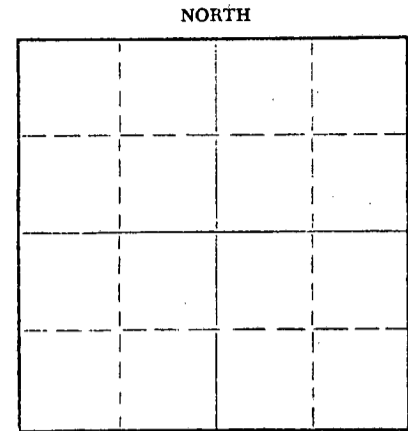

Locate well correctly on above Section Plat

Name of Conservation Agent who supervised plugging of this well W. L. Nichols, Morland, Kansas

Producing formation _____ Depth to top _____ Bottom _____ Total Depth of Well 3908 Feet

Show depth and thickness of all water, oil and gas formations.

OIL, GAS OR WATER RECORDS

CASING RECORD

FORMATION	CONTENT	FROM	TO	SIZE	PUT IN	PULLED OUT
Surface		0	201'	8 5/8"	7-5-63	

Describe in detail the manner in which the well was plugged, indicating where the mud fluid was placed and the method or methods used in introducing it into the hole. If cement or other plugs were used, state the character of same and depth placed, from _____ feet to _____ feet for each plug set.

Filled hole with heavy drilling mud and set Plug #1
at 540' with 20 sacks of cement 1/4 sack hulls. Set
Plug #2 at 195' with 20 sacks cement and 1/2 sack hulls.
Set plug #2 at 40' with 10 sackso of cement.

RECEIVED
STATE CORPORATION COMMISSION

JUL 22 1963

CONSERVATION DIVISION
Wichita, Kansas

7-22-63

(If additional description is necessary, use BACK of this sheet)

Name of Plugging Contractor Chief Drilling Company, Inc.

Address P. O. Box 797, Great Bend, Kansas

STATE OF Kansas COUNTY OF Sedgwick, ss.

James R. Daniels (employee of owner) or (owner or operator) of the above-described well, being first duly sworn on oath, says: That I have knowledge of the facts, statements, and matters herein contained and the log of the above-described well as filed and that the same are true and correct. So help me God.

(Signature) James R Daniels

James R. Daniels - D & D Drilling Co., Inc.
308 Schweiter Bldg. (Address) Wichita, Kansas

SUBSCRIBED AND SWORN to before me this 19 day of July, 19 63

Colleen Chapple
Colleen Chapple

Notary Public.

My commission expires 11-18-66



