

15179-20045-0000


STATE OF KANSAS
STATE CORPORATION COMMISSION

Give All Information Completely
Make Required Affidavit
Mail or Deliver Report to:
Conservation Division
State Corporation Commission
212 No. Market
Wichita, Kansas

WELL PLUGGING RECORD

Sheridan County. Sec. 2 Twp. 8 Rge. 26 (E) W (W)
Location as "NE/CNW%SW%" or footage from lines SW SE NW
Lease Owner Benjamin B. Tepper
Lease Name Niblock Well No. 2
Office Address 7751 Caroldelet Ave, Clayton, Mo.
Character of Well (completed as Oil, Gas or Dry Hole) Dry Hole
Date well completed October 9 19 67
Application for plugging filed October 9 19 67
Application for plugging approved October 9 19 67
Plugging commenced October 9 19 67
Plugging completed October 9 19 67
Reason for abandonment of well or producing formation Dry Hole

NORTH

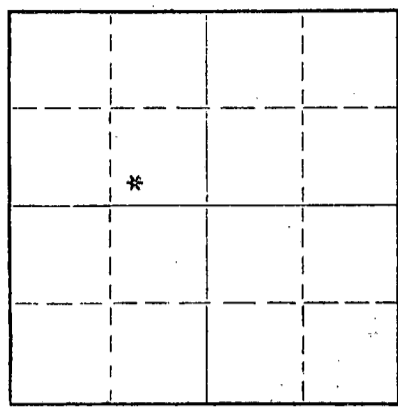

Locate well correctly on above Section Plat

If a producing well is abandoned, date of last production 19
Was permission obtained from the Conservation Division or its agents before plugging was commenced? Yes

Name of Conservation Agent who supervised plugging of this well W. I. Nichol
Producing formation Depth to top Bottom Total Depth of Well 4173 Feet
Show depth and thickness of all water, oil and gas formations.

OIL, GAS OR WATER RECORDS

CASING RECORD

FORMATION	CONTENT	FROM	TO	SIZE	PUT IN	PULLED OUT
		0'	220'	7"	213'	

Describe in detail the manner in which the well was plugged, indicating where the mud fluid was placed and the method or methods used in introducing it into the hole. If cement or other plugs were used, state the character of same and depth placed, from feet to feet for each plug set.

- #1 Plug ~~XX~~ from 1020 to 720 w/55 sacks cement
- #2 Plug from 240 to 115 w/15 sacks cement
- #3 Plug from 40 to surface w/10 sacks cement

FILED
OCT 19 1967
CONSERVATION DIVISION
Wichita, Kansas
10-19-67

(If additional description is necessary, use BACK of this sheet)

Name of Plugging Contractor Halliburton Company
Address Hill City, Kansas

STATE OF Kansas, COUNTY OF Graham, ss.
Louis Edgett (employee of owner or (owner or operator) of the above-described well, being first duly sworn on oath, says: That I have knowledge of the facts, statements, and matters herein contained and the log of the above-described well as filed and that the same are true and correct. So help me God.

(Signature) Louis Edgett
P. O. Box D, Hill City, Kansas (Address)

Sworn to before me this 19 day of October, 1967
Donald Law
Notary Public.



15-179-20045-00-00

CONTRACTOR'S WELL LOG

COMPANY:	BENJAMIN B. TEPPER
CONTRACTOR:	PAINE DRILLING CO., INC.
WELL:	NIBLOCK "A" # 2
LOCATION:	S/2 SE NW Sec. 2-8S-26W Sheridan County, Kansas
COMMENCED:	SEPTEMBER 28, 1967
COMPLETED:	OCTOBER 9, 1967

0	220	Surface Soils
220	1530	Shale & Sand
1530	1905	Sand & Shale
1905	2135	Shale & Shells
2135	2162	Shale & Shells
2162	2200	Anhydrite
2200	2290	Shale
2290	2880	Shale & Shells
2880	3095	Lime & Shale
3095	3175	Shells & Lime
3175	3240	Lime
3240	3370	Lime & Shale
3370	3540	Lime
3540	3645	Lime & Shale
3645	3890	Lime
3890	3970	Lime & Shale
3970	4173	Lime

RECEIVED
STATE CONSERVATION COMMISSION
OCT 19 1967
10-19-67
CONSERVATION DIVISION
Wichita, Kansas


SET 7" SURFACE AT 220' W/125 Sacks HA5

DRY AND ABANDONED

WE HEREBY CERTIFY THAT THE ABOVE IS A CORRECT AND ACCURATE LOG OF THE ABOVE MENTIONED WELL, AS SHOWN ON THE DAILY DRILLING REPORTS.

PAINE DRILLING CO., INC.

BY: Louis Edgett
Bookkeeper

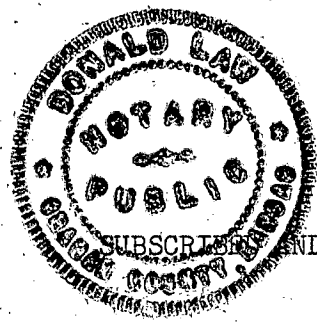

SUBSCRIBER AND SWORN TO BEFORE ME THIS 11th DAY OF OCTOBER, 1967

Donald Law
NOTARY PUBLIC