

15-065-20335-00-00

WELL PLUGGING RECORD

STATE OF KANSAS
STATE CORPORATION COMMISSION

Give All Information Completely
Make Required Affidavit
Mail or Deliver Report to
Conservation Division
State Corporation Commission

P. O. Box 17027
Wichita, Kansas 67217
NORTH

Graham County, Sec. 28 Twp. 8 Rge. 25 (E) (W) X


Location as "NE/CNW/SW" or footage from lines NW NW SE
Lease Owner Bank off Oil Co.
Lease Name Culley Well No. #1
Office Address P.O. Drawer 2479 Tulsa, Okla.
Character of Well (completed as Oil, Gas or Dry Hole)
Date well completed 19
Application for plugging filed 8-24-72 19
Application for plugging approved 19
Plugging commenced 8-30-72 19
Plugging completed 9-5-72 19
Reason for abandonment of well or producing formation

If a producing well is abandoned, date of last production 19
Was permission obtained from the Conservation Division or its agents before plugging was commenced?

Name of Conservation Agent who supervised plugging of this well Edgar J. Eves

Producing formation Depth to top Bottom Total Depth of Well 4042' Feet

Show depth and thickness of all water, oil and gas formations.

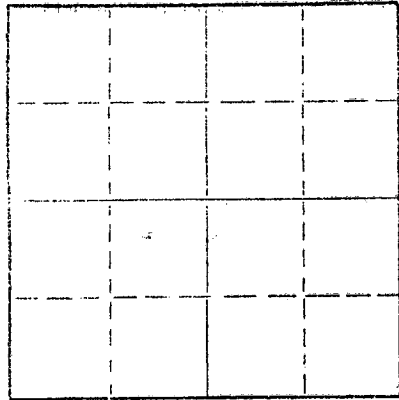

Locate well correctly on above Section Plat

OIL, GAS OR WATER RECORDS

CASING RECORD

FORMATION	CONTENT	FROM	TO	SIZE	PUT IN	PULLED OUT
				5 1/2"	4038'	2846.82'
				8 5/8"	209'	

Describe in detail the manner in which the well was plugged, indicating where the mud fluid was placed and the method or methods used in introducing it into the hole. If cement or other plugs were used, state the character of same and depth placed, from feet to feet for each plug set.

Made bottom hole plug back with sand to 3850'. Mixed and ran 5 sacks cement thru dump bailer.
Squeezed hole with 5 sacks hulls and 13 sacks gel. 110 cu. ft. cement from 1300' - 975'.
19 sacks gel, from 975' 0 225'. 30 cu ft. cement from 225' 0 150'. 3 sacks gel from 150' to 30'. 10 cu. ft. cement from 30' to base of cellar.

RECEIVED
STATE CORPORATION COMMISSION
SEP 8 1972
CONSERVATION DIVISION
Wichita, Kansas


Name of Plugging Contractor Southwest Casing Pulling Co. 9-8-72
Address Box 364 Great Bend, Kansas

STATE OF Kansas COUNTY OF Barton, ss.

Southwest Casing Pulling Co. (employee of owner) or (owner or operator) of the above-described well, being first duly sworn on oath, says: That I have knowledge of the facts, statements, and matters herein contained and the log of the above-described well and that the same are true and correct. So help me God.

(Signature) W. C. Spencer
Box 364 Great Bend, Kansas
(Address)

Subscribed and sworn to before me this 7 day of Sept. 19 72

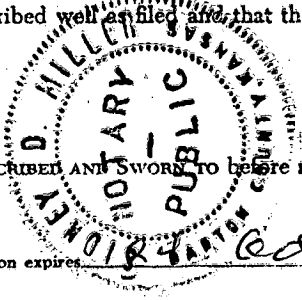

My commission expires October 1972 Notary Public.