


15-065-21293-00-00

STATE OF KANSAS
STATE CORPORATION COMMISSION

WELL PLUGGING RECORD

Give All Information Completely
Make Required Affidavit
Mail or Deliver Report to
Conservation Division
State Corporation Comm.
245 North Water
Wichita, KS 67202

Graham County, Sec. 31 Twp. 8 Rge. 25 E/W
Location as "NE/CNW $\frac{1}{4}$ SW $\frac{1}{4}$ " or footage from lines
NW NW NW 440' S of North line 440' E of West Line
Lease Owner Helberg Oil Company
Lease Name Helberg Well No. 1
Office Address Box 32 Morland, Kansas 67650
Character of Well (Completed as Oil, Gas or Dry Hole) Dry hole

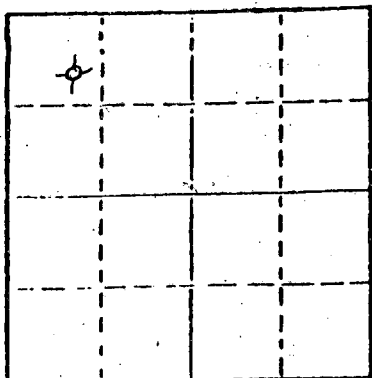

Locate well correctly on above
Section Plot

Date Well completed 9-7 1980
Application for plugging filed 9-7 1980
Application for plugging approved 9-7 1980
Plugging commenced 9-7 1980
Plugging completed 9-7 1980
Reason for abandonment of well or producing formation dry hole

If a producing well is abandoned, date of last production 19

Was permission obtained from the Conservation Division or its agents before plugging was commenced? yes

Name of Conservation Agent who supervised plugging of this well Gilbert Baltazor
Producing formation _____ Depth to top _____ Bottom _____ Total Depth of Well 4075'
Show depth and thickness of all water, oil and gas formations.

OIL, GAS OR WATER RECORDS

CASING RECORD

FORMATION	CONTENT	FROM	TO	SIZE	PUT IN	PULLED OUT
surface		0	210'	8 5/8"	200	0

Describe in detail the manner in which the well was plugged, indicating where the mud fluid was placed and the method or methods used in introducing it into the hold. If cement or other plugs were used, state the character of same and depth placed, from _____ feet to _____ feet for each plug set.

1st Plug set at 1100' with 70 sacks of cement 50-50 Poz 6% gel

2nd Plug set at 200' with 20 sacks of cement 50-50 Poz 6% gel

3rd Plug set at 40' with 10 Sacks of cement 50-50 Poz 6% gel

5 sacks cement in rathole

(If additional description is necessary, use BACK of this report)

Name of Plugging Contractor Sun Oilwell Cementing

RECEIVED
STATE CORPORATION COMMISSION
SEP 26 1980
CONSERVATION DIVISION
Wichita, Kansas
9-26-80

STATE OF Kansas COUNTY OF Graham
Jerry M. Helberg (employee of owner) or (owner or operator)

of the above-described well, being first duly sworn on oath, says: That I have knowledge of the facts, statements, and matters herein contained and the log of the above-described well as filed and that the same are true and correct. So help me God.

(Signature) Jerry M. Helberg
Box 32 Morland, Kansas 67650 (Address)

SUBSCRIBED AND SWORN TO before me this 22 day of Sept, 1980

Faye E. Minium
Notary Public.

My commission expires 

15-065-21293-00-00

DRILLERS LOG

HELBERG #1

CASING RECORD:

8 5/8" set at 200'

TOTAL DEPTH:

4075'

OPERATOR: Helberg Oil Company

CONTRACTOR: Helberg Oil Company

COMMENCED: August 26, 1980

COMPLETED: September 7, 1980

DESCRIPTION:

NW NW NW
Sec. 31-8-25 Graham County, Kansas

FORMATION	FROM	TO	REMARKS
Sand & Shale	0	100	
Sand & Shale	100	220	
Sand & Shale	220	539	
Shale	539	1142	
Sand & Shale	1142	1342	
Shale	1342	1600	
Lime & Shale	1600	1770	
Shale & Lime (Anhydrite)	1770	2095	
Shale	2125	2360	
Lime & Shale	2360	2420	
Shale & Lime	2420	2535	
Lime & Shale	2535	2615	
Lime & Shale	2615	2730	
Shale & Lime	2730	2789	
Lime & Shale	2789	2830	
Lime & Shale	2830	2960	
Shale & Lime	2960	3040	
Lime & Shale	3040	3135	
Lime & Shale	3135	3272	
Shale & Lime	3272	3358	
Lime & Shale	3358	3442	
Lime & Shale	3442	3527	
Lime & Shale	3527	3635	
Lime	3635	3692	
Lime	3692	3751	
Lime & Shale	3751	3820	
Lime	3820	3873	
Lime	3873	3936	
Lime	3936	3980	
Lime	3980	4035	
Lime	4035	4075	
T.D.	4075		

9-26-80
RECEIVED
 STATE CORPORATION COMMISSION
SEP 26 1980
 CONSERVATION DIVISION
 Wichita, Kansas

I certify that the above is a true and correct copy of the log to the best of my knowledge.

HELBERG OIL COMPANY
Jerry M. Helberg
 Jerry M. Helberg

Subscribed and sworn to before me this 22nd day of September, 1980.

Jay E. Quinn
 Notary Public

My commission expires

