

WELL PLUGGING RECORD

Graham County, Sec. 31 Twp. 8 Rge. 25 (E) (W)

Location as "NE/CNW/SW" or footage from lines SE NW SE

Lease Owner Jerry M. Helberg

Lease Name Helberg Well No. #1

Office Address Box 32 Morland, Ks. 67650

Character of Well (completed as Oil, Gas or Dry Hole) Dry Hole

Date well completed 9-14 19 82

Application for plugging filed 9-14 19 82

Application for plugging approved 9-14 19 82

Plugging commenced 9-14 19 82

Plugging completed 9-14 19 82

Reason for abandonment of well or producing formation Dry Hole


If a producing well is abandoned, date of last production 19

Was permission obtained from the Conservation Division or its agents before plugging was commenced? Yes

Name of Conservation Agent who supervised plugging of this well Gilbert Balthazar

Producing formation Depth to top Bottom Total Depth of Well 2508' Feet

Show depth and thickness of all water, oil and gas formations.

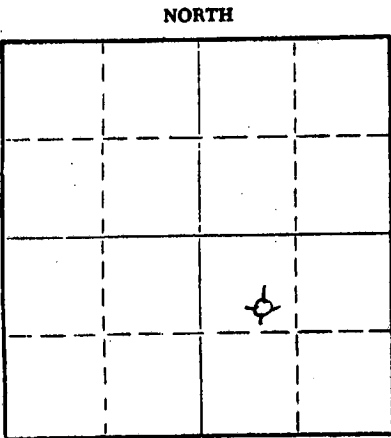

Locate well correctly on above Section Plat

OIL, GAS OR WATER RECORDS

CASING RECORD

FORMATION	CONTENT	FROM	TO	SIZE	PUT IN	PULLED OUT
Surface		0	208'	8 5/8"	208'	0

Describe in detail the manner in which the well was plugged, indicating where the mud fluid was placed and the method or methods used in introducing it into the hole. If cement or other plugs were used, state the character of same and depth placed, from feet to feet for each plug set.

1st. Plug set at 1350' with 100 sacks common cement 50-50 Poz 3% Cal Cl 4% Gel  
 2nd. Plug set at 250' with 40 sacks common cement 50-50 Poz 3% Cal Cl 4% Gel  
 3rd. Plug set at 40' with 10 sacks common cement 50-50 Poz 3% Cal Cl 4% Gel  
 10 sacks in rathole  
 Heavy drilling mud between each plug

RECEIVED  
STATE CORPORATION COMMISSION  
NOV 3 1982  
CONSERVATION DIVISION  
Wichita, Kansas

(If additional description is necessary, use BACK of this sheet)  
 Name of Plugging Contractor Sun Oilwell Cementing  
 Address Hays, Ks. 67601

STATE OF Kansas, COUNTY OF Graham, ss.  
 Jerry M. Helberg (employee of owner) or (owner or operator) of the above-described well, being first duly sworn on oath, says: That I have knowledge of the facts, statements, and matters herein contained and the log of the above-described well as filed and that the same are true and correct. So help me God.

(Signature) Jerry M. Helberg  
 Box 32 Morland, Ks. 67650  
 (Address)

SUBSCRIBED AND SWORN to before me this 2nd day of November, 1982

Janice Richman  
 Notary Public.

