


Give All Information Completely
Make Required Affidavit
Mail or Deliver Report to:
Conservation Division
State Corporation Commission
212 No. Market
Wichita, Kansas

WELL PLUGGING RECORD

NORTH

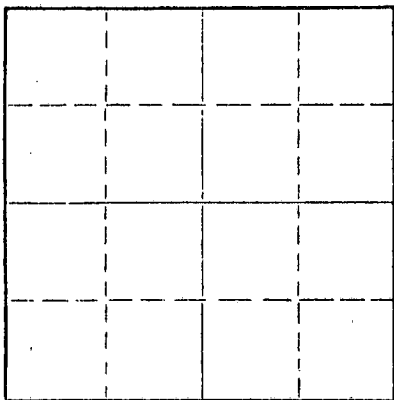

Locate well correctly on above
Section Plat

Sheridan County. Sec. 30 Twp. 8 Rge. 26 (E) W (W)
Location as "NE/CNW%SW%" or footage from lines NE SE
Lease Owner Leo J. Dreiling Oil Company
Lease Name Sutor Well No. 5
Office Address Route 2, Victoria, Kansas 67671
Character of Well (completed as Oil, Gas or Dry Hole) Dry Hole
Date well completed 9-16 19 68
Application for plugging filed 9-16 19 68
Application for plugging approved 9-16 19 68
Plugging commenced 9-16 19 68
Plugging completed 9-16 19 68
Reason for abandonment of well or producing formation Dry Hole

If a producing well is abandoned, date of last production _____ 19____
Was permission obtained from the Conservation Division or its agents before plugging was commenced? Yes

Name of Conservation Agent who supervised plugging of this well W. L. Nichols
Producing formation _____ Depth to top _____ Bottom _____ Total Depth of Well _____ Feet
Show depth and thickness of all water, oil and gas formations.

OIL, GAS OR WATER RECORDS

CASING RECORD

FORMATION	CONTENT	FROM	TO	SIZE	PUT IN	PULLED OUT
Surface Pipe				8 5/8"	185'	

Describe in detail the manner in which the well was plugged, indicating where the mud fluid was placed and the method or methods used in introducing it into the hole. If cement or other plugs were used, state the character of same and depth placed, from _____ feet to _____ feet for each plug set.

1st. plug was set @ 1285' with 70 sacks cement
2nd. plug was set @ 215' with 20 sacks cement
3rd. plug was set @ 40' with 10 sacks cement
Cementing to bottom of cellar

RECEIVED
STATE CORPORATION COMMISSION
SEP 18 1968
CONSERVATION DIVISION
Wichita, Kansas
9-18-1968

(If additional description is necessary, use BACK of this sheet)

Name of Plugging Contractor L. J. Dreiling & Sons, Inc.
Address Route 2, Victoria, Kansas 67671

STATE OF KANSAS, COUNTY OF ELLIS, ss.
I, Leo F. Dreiling (employee of owner) or (~~owner~~) of the above-described

well, being first duly sworn on oath, says: That I have knowledge of the facts, statements, and matters herein contained and the log of the above-described well as filed and that the same are true and correct. So help me God.

(Signature) Leo F. Dreiling
LEO F. DREILING, ROUTE 2, VICTORIA, KANSAS 67671
(Address)

SUBSCRIBED AND SWORN TO before me this 17th day of September, 19 68

My commission expires September 19, 1970
Joseph A. Hess
JOSEPH A. HESS Notary Public.



L. J. DREILING AND SONS, INC.

Victoria, Kansas 67671

WELL LOG

Company	Leo J. Dreiling Oil Company Route 2 Victoria, Kansas 67671	Sec. 30	Twp. 8	Rng. 26
Farm	Sutor No. 5	Location	NE SE	
Total Depth	3970'	County	Sheridan	
Comm.	9-9-68	Comp.	9-16-68	
Contractor	L. J. Dreiling & Sons, Inc. Victoria, Kansas 67671	Elevation:	2606'	K. B.
			2603'	D. F.
			2601'	G. R.
	Casing Record	Cement Record	Production: D & A	
	185' - 8 5/8"	150 sacks cement		

Figures Indicate Bottom of Formations

0'	40'	Surface Soil & Gravel
40'	70'	Gravel & Sand
70'	125'	Clay & Sand
125'	130'	Clay & Sand
130'	170'	Sand
170'	185'	Blue Shale
185'	1610'	Shale & Sand
1610'	1825'	Gyp & Shale
1825'	2004'	Sand
2004'	2224'	Shale & Redbed
2224'	2262'	Anhy.
2262'	2820'	Shale & Chalk
2820'	3750'	Shale & Lime
3750'	3970'	Lime
3970'	T.D.	

RECEIVED
 STATE CORPORATION COMMISSION
 SEP 18 1968
 CONSERVATION DIVISION
 Wichita, Kansas
 9-18-68

STATE OF KANSAS)
)ss.
 COUNTY OF ELLIS)

I, Leo F. Dreiling, of the L. J. Dreiling & Sons, Inc., upon oath states that the above and foregoing is a true and correct copy from the Daily Drilling Report from your Sutor #5.

Leo F. Dreiling

 LEO F. DREILING

Subscribed and sworn to before me this 17th day of September 1968.



Joseph A. Hess

 JOSEPH A. HESS NOTARY PUBLIC

My commission expires: September 19, 1970