

15-179-20257-00-00

STATE OF KANSAS
STATE CORPORATION COMMISSION

Form CP-4


Give All Information Completely
Make Required Affidavit
Mail or Deliver Report to:
Conservation Division
State Corporation Commission
212 No. Market
Wichita, Kansas 67202

WELL PLUGGING RECORD

Sheridan County, Sec. 31 Twp. 8 Rge. 26 (E) E (W)

Location as "NE/CNWxSWx" or footage from lines C SW NE
Lease Owner L. J. Dreiling & Sons, Inc.
Lease Name Feldt Well No. 1
Office Address Victoria, Kansas 67671
Character of Well (completed as Oil, Gas or Dry Hole) Dry Hole
Date well completed 6-20 1970
Application for plugging filed 6-20 1970
Application for plugging approved 6-20 1970
Plugging commenced 6-20 1970
Plugging completed 6-20 1970
Reason for abandonment of well or producing formation Dry Hole

NORTH

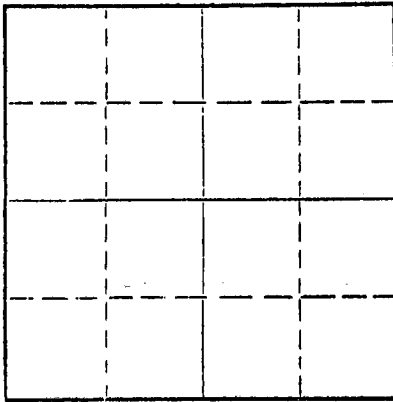

Locate well correctly on above
Section Plat

If a producing well is abandoned, date of last production 19
Was permission obtained from the Conservation Division or its agents before plugging was commenced? Yes

Name of Conservation Agent who supervised plugging of this well Bill Nichols
Producing formation _____ Depth to top _____ Bottom _____ Total Depth of Well _____ Feet
Show depth and thickness of all water, oil and gas formations.

OIL, GAS OR WATER RECORDS

CASING RECORD

FORMATION	CONTENT	FROM	TO	SIZE	PUT IN	PULLED OUT
Surface Pipe				8 5/8"	223'	

Describe in detail the manner in which the well was plugged, indicating where the mud fluid was placed and the method or methods used in introducing it into the hole. If cement or other plugs were used, state the character of same and depth placed, from _____ feet to _____ feet for each plug set.

1st plug was set at 1325' with 70 sacks cement
2nd plug was set at 250' with 20 sacks cement
3rd plug was set at 40' with 10 sacks cement

RECEIVED
STATE CORPORATION COMMISSION
JUN 29 1970
CONSERVATION DIVISION
Wichita, Kansas
06-29-1970

(If additional description is necessary, use BACK of this sheet)

Name of Plugging Contractor L. J. Dreiling & Sons, Inc.
Address Route #2, Victoria, Kansas 67671

STATE OF KANSAS, COUNTY OF ELLIS, ss.

Leo F. Dreiling (employee of owner) or (~~owner or operator~~) of the above-described well, being first duly sworn on oath, says: That I have knowledge of the facts, statements, and matters herein contained and the log of the above-described well as filed and that the same are true and correct. So help me God.

(Signature) Leo F. Dreiling
LEO F. DREILING, ROUTE 2, VICTORIA, KANSAS 67671
(Address)

SUBSCRIBED AND SWORN to before me this 26th day of June, 1970.

My commission expires September 19, 1970

Joseph A. Hess
JOSEPH A. HESS

Notary Public.

L. J. DREILING AND SONS, INC.

Victoria, Kansas 67671

WELL LOG

15-179-20257-00-00

Company L. J. Dreiling & Sons, Inc.
Victoria, Kansas 67671

Sec. 31 Twp. 8S Rng. 26W

Farm Feldt No. 1

Location C SW NE

Total Depth 4000'

County Sheridan

Comm. 6-16-70 Comp. 6-20-70

Elevation: 2603' K. B.

Contractor L. J. Dreiling & Sons, Inc.
Victoria, Kansas 67671

2600' D. F.

2598' G. R.

Casing Record

Cement Record

Production:

223' - 8 5/8"

150 sacks cement

D & A

Figures Indicate Bottom of Formations


0'	90'	Surface Soil & Clay
90'	170'	Sand
170'	234'	Shale
234'	1650'	Shale & Sand
1650'	1725'	Shale & Shells
1725'	1840'	Shale
1840'	2005'	Sand
2005'	2227'	Shale & Red Bed
2227'	2260'	Anhydrite
2260'	2798'	Shale & Shell
2798'	3082'	Lime & Shale
3082'	3245'	Lime & Shale
3245'	3460'	Lime & Shale
3460'	3610'	Lime & Shale
3610'	3675'	Lime
3675'	3772'	Lime & Shale
3772'	3825'	Lime
3825'	3940'	Lime
3940'	4000'	Lime
4000'	T.D.	

STATE OF KANSAS)
)ss
COUNTY OF ELLIS)

I, Leo F. Dreiling, of the L. J. Dreiling & Sons, Inc., upon oath states that the above and foregoing is a true and correct copy from the Daily Drilling Report from the Feldt #1.


LEO F. DREILING

Subscribed and sworn to before me this 26th day of June, 1970.


JOSEPH A. HESS - NOTARY PUBLIC

My Commission Expires: September 19, 1970

WICHITA COUNTY
CONSERVATION DIVISION
JUN 28 1970
STATE CONSERVATION COMMISSION
RECEIVED