


STATE OF KANSAS
STATE CORPORATION COMMISSION

Give All Information Completely
Make Required Affidavit
Mail or Deliver Report to:
Conservation Division
State Corporation Commission
800 Bitting Building
Wichita, Kansas

WELL PLUGGING RECORD

Sheridan County. Sec. 32 Twp. 8 Rge. (E) 26 (W)

Location as "NE/CNW/SW" or footage from lines SE SW SE
Lease Owner Anderson-Prichard Oil Corporation
Lease Name Pratt Well No. 1
Office Address 314 Orpheum Building, Wichita, Kansas
Character of Well (completed as Oil, Gas or Dry Hole) Dry Hole
Date well completed September 22, 19 53
Application for plugging filed September 22, 19 53
Application for plugging approved September 22, 19 53
Plugging commenced September 22, 19 53
Plugging completed September 22, 19 53
Reason for abandonment of well or producing formation Dry

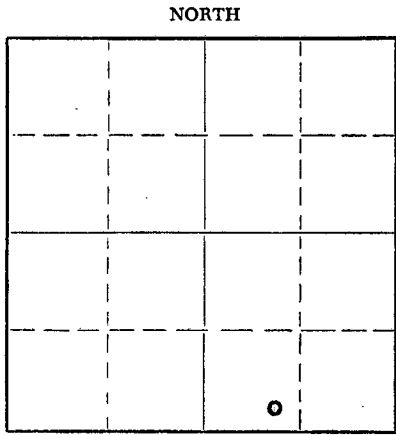

Locate well correctly on above Section Plat

If a producing well is abandoned, date of last production _____ 19____
Was permission obtained from the Conservation Division or its agents before plugging was commenced? _____

Name of Conservation Agent who supervised plugging of this well _____
Producing formation _____ Depth to top _____ Bottom _____ Total Depth of Well 4350 Feet
Show depth and thickness of all water, oil and gas formations.

OIL, GAS OR WATER RECORDS CASING RECORD

FORMATION	CONTENT	FROM	TO	SIZE	PUT IN	PULLED OUT
				8 5/8"	245'	none

Describe in detail the manner in which the well was plugged, indicating where the mud fluid was placed and the method or methods used in introducing it into the hole. If cement or other plugs were used, state the character of same and depth placed, from _____ feet to _____ feet for each plug set.

Bottom plug at 240 ft. with 1/2 sk. hulls and 15 sx. cement and mud. Top plug at 40 ft. with 1/2 sk. hulls and 10 sx. cement. Mud to surface.

(If additional description is necessary, use BACK of this sheet)



Name of Plugging Contractor Graham-Messman-Rinehart Oil Company
Address P. O. Box 1033, Wichita, Kansas

STATE OF Kansas, COUNTY OF Sedgwick, ss. J. A. Gilliland (employee of owner) ~~not a record keeper~~ of the above-described well, being first duly sworn on oath, says: That I have knowledge of the facts, statements, and matters herein contained and the log of the above-described well as filed and that the same are true and correct. So help me God.

(Signature) J. A. Gilliland
P. O. Box 1033, Wichita, Kansas
(Address)

SUBSCRIBED AND SWORN TO before me this 30th day of September, 19 53

My commission expires December 1, 1956 Barbara J. Scott Notary Public.

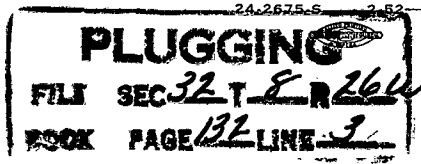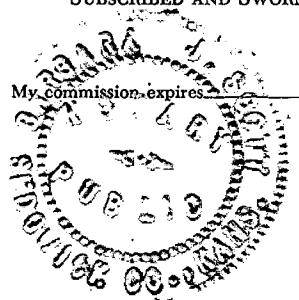

10-2-1953
DIVISION

PRATT #1

WELL RECORD

Location: SE SW SE 32-8-26W
 Sheridan County, Kansas
 Commenced: September 10, 1953
 Operator: Anderson-Prichard Oil Corporation
 314 Orpheum Building, Wichita, Kansas
 Completed: September 22, 1953
 Elevation: 2572 K.B.
 Contractor: Graham-Messman-Rinehart Drilling Co.
 1005 E. 2nd Street, Wichita, Kansas
 Production: D & A
 Casing Record: 8 5/8" @ 245'

LOG

Sand & Shale 130
 Shale 165
 Shale & Shells 245
 Shale & Sand 600
 Shale & Shells 1130
 Shale 1195
 Sand 1285
 Shale & Shells 1585
 Shale 1780
 Sand 1960
 Shale & Shells 2300
 Shale & Red Bed 2520
 Shale & Shells 2655
 Lime & Shale 2845
 Lime & Shale 2990
 Lime & Shale 3115
 Lime & Shale 3200
 Lime & Shale 3320
 Lime & Shale 3465
 Lime & Shale 3587
 Lime & Shale 3675
 Lime 3730
 Lime 3770
 Lime 3802
 Lime 3840
 Lime 3849
 Lime 3902
 Lime & Shale 3975
 Lime 4030
 Lime & Shale 4077
 Lime & Shale 4140
 Lime & Shale 4225
 Conglomerate 4250
 Lime 4270
 Lime 4315
 Mississippi & Arbuckle 4350 T.D.

TOPS

Heebner - 3668 (-1096)
 Toronto - 3690 (-1118)
 Lansing - 3708 (-1136)
 Base K.C. - 3924 (-1352)
 Conglomerate - 4226 (-1654)
 Mississippi - 4246 (-1674)
 Arbuckle - 4317 (-1745)

The undersigned, GRAHAM-MESSMAN-RINEHART DRILLING COMPANY, hereby certifies that the above log is a true and correct log of the formation encountered in drilling the above well as reflected by the Daily Drilling Reports.

GRAHAM-MESSMAN-RINEHART DRILLING COMPANY

By: J. A. Gilliland
 J. A. Gilliland

Subscribed and sworn to before me this 30th day of September, 1953.

Barbara J. Scott
 Notary Public

PLUGGING RECEIVED
 STATE CORPORATION COMMISSION
 FILE SEC 32-T-8-R-264
 BOOK PAGE 137 LINE 3
 OCT - 2 1953
 CONSERVATION DIVISION
 Wichita, Kansas

10-2-1953

My commission expires: December 1, 1956