

3

TYPE

AFFIDAVIT OF COMPLETION FORM

ACO-1 WELL HISTORY

Compt. _____

SIDE ONE

Two (2) copies of this form shall be filed with the Kansas Corporation Commission, 200 Colorado Derby Building, Wichita, Kansas 67202, within thirty (30) days after the completion of a well, regardless of how the well was completed.

F Attach separate letter of request if the information is to be held confidential. If confidential, only file one copy. Information on Side One will be of public record and Side Two will then be held confidential.

Applications must be made on dual completion, commingling, salt water disposal, injection and temporarily abandoned wells.

C Attach one copy only wireline logs (i.e. electrical log, sonic log, gamma ray neutron log, etc.). (Rules 82-2-105 & 82-2-125) KCC# (316) 263-3238.

LICENSE # 6114 EXPIRATION DATE 6-30-83

OPERATOR Don E. Pratt Oil Operations API NO. 15-179-20,666-00-00

ADDRESS P.o. Box 370 COUNTY Sheridan
Hays, KS 67601 FIELD

** CONTACT PERSON Don E. Pratt PROD. FORMATION dry hole
PHONE 913-625-3446

PURCHASER -0- LEASE Helen Pratt

ADDRESS WELL NO. #1-34

DRILLING CONTRACTOR Murfin Drilling Co., WELL LOCATION SE SE SE

ADDRESS 617 Union Center 330 Ft. from S Line and

Wichita, KS 67202 330 Ft. from E Line of

the SE (Qtr.) SEC34 TWP8S RGE26W .

PLUGGING CONTRACTOR Murfin Drilling Co.,

ADDRESS 617 Union Center

Wichita, KS 67202

TOTAL DEPTH 4020' PBTD

SPUD DATE 10-7-82 DATE COMPLETED 10-13-82

ELEV: GR 2597 DF 2600 KB 2602


DRILLED WITH (CABLE) (ROTARY) (AIR) TOOLS.

DOCKET NO. OF DISPOSAL OR REPRESSURING WELL BEING USED TO DISPOSE OF WATER FROM THIS LEASE

Amount of surface pipe set and cemented 202 DV Tool Used? no

THIS AFFIDAVIT APPLIES TO: (Circle ONE) - Oil, Gas, Shut-in Gas, Dry, Disposal, Injection, Temporarily Abandoned, OWWO. Other

ALL REQUIREMENTS OF THE STATUTES, RULES AND REGULATIONS PROMULGATED TO REGULATE THE OIL AND GAS INDUSTRY HAVE BEEN FULLY COMPLIED WITH.

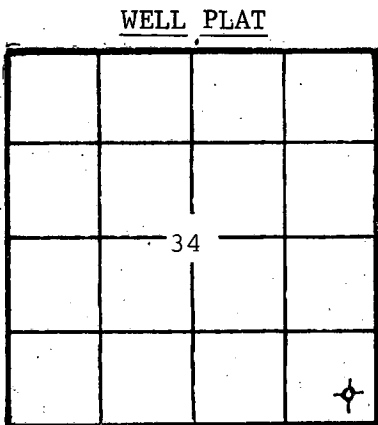

(Office Use Only)
KCC ✓
KGS ✓
SWD/REP ✓
PLG. ✓

A F F I D A V I T

Don E. Pratt, being of lawful age, hereby certifies that:

I am the Affiant, and I am familiar with the contents of the foregoing Affidavit. The statements and allegations contained therein are true and correct.

Don E. Pratt
(Name) Don E. Pratt

SUBSCRIBED AND SWORN TO BEFORE ME this 29th day of October, 1982.

HELEN UBERT
NOTARY PUBLIC
STATE OF KANSAS
MY APPT. EXPIRES JULY 22, 1985

MY COMMISSION EXPIRES: 7-22-85

Helen Ubert
(NOTARY PUBLIC) Helen Ubert

RECEIVED
STATE CORPORATION COMMISSION
NOV 1 11-1-1982
CONSERVATION DIVISION
Wichita, Kansas

** The person who can be reached by phone regarding any questions concerning this information.

OPERATOR Don E. Pratt

LEASE Helen Pratt

SEC. 34 TWP. 8 RGE. 26

WELL NO. 1-34

FILL IN WELL INFORMATION AS REQUIRED:

Show all important zones of porosity and contents thereof; cored intervals, and all drill-stem tests, including depth interval tested, cushion used, time tool open, flowing and shut-in pressures, and recoveries.

SHOW GEOLOGICAL MARKERS, LOGS RUN, OR OTHER DESCRIPTIVE INFORMATION.

FORMATION DESCRIPTION, CONTENTS, ETC.	TOP	BOTTOM	NAME	DEPTH
Check if no Drill Stem Tests Run.				
Shale-----		2010'		
Shale & Sand---		2235'		
Anhydrite----		2269		
Shale & shells -		2292'		
Sand & shale---		3061'		
Shale & lime---		4020'		
If additional space is needed use Page 2, Side 2.				

Report of all strings set — surface, intermediate, production, etc. CASING RECORD (New) or (Used)

Purpose of string	Size hole drilled	Size casing set (in O.D.)	Weight lbs/ft.	Setting depth	Type cement	Sacks	Type and percent additives
surface csg.	12½"	8 5/8"	20#	202'	COS	135	

LINER RECORD

PERFORATION RECORD

Top, ft.	Bottom, ft.	Sacks cement	Shots per ft.	Size & type	Depth interval

TUBING RECORD		
Size	Setting depth	Packer set at

ACID, FRACTURE, SHOT, CEMENT SQUEEZE RECORD

Amount and kind of material used	Depth interval treated

Date of first production	Producing method (flowing, pumping, gas lift, etc.)	Gravity
--------------------------	---	---------

Estimated Production - I.P.	Oil bbls.	Gas bbls.	Water %	Gas-oil ratio	CFPB
Disposition of gas (vented, used on lease or sold)			Perforations		