


STATE OF KANSAS  
STATE CORPORATION COMMISSION

Form CP-4

Give All Information Completely  
Make Required Affidavit  
Mail or Deliver Report to:  
Conservation Division  
State Corporation Commission  
212 No. Market  
Wichita, Kansas

WELL PLUGGING RECORD

NORTH

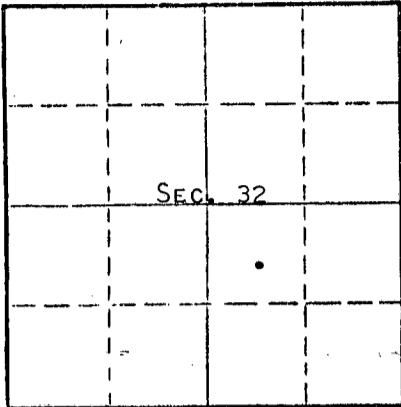

Locate well correctly on above  
Section Plat

SHERIDAN County. Sec. 32 Twp. 8s Rge. 26 (E) (W)  
Location as "NE/CNW/SW" or footage from lines App. NW SE  
Lease Owner PETROLEUM, INC.,  
Lease Name PRATT Well No. 1  
Office Address R.R. #2, GREAT BEND, KANSAS  
Character of Well (completed as Oil, Gas or Dry Hole) DRY HOLE  
Date well completed JUNE 28 19 67  
Application for plugging filed JUNE 28 19 67  
Application for plugging approved JUNE 28 19 67  
Plugging commenced JUNE 28 19 67  
Plugging completed JUNE 28 19 67  
Reason for abandonment of well or producing formation NO PRODUCIBLE ZONE

If a producing well is abandoned, date of last production NONE 19  
Was permission obtained from the Conservation Division or its agents before plugging was commenced? YES

Name of Conservation Agent who supervised plugging of this well W. L. NICHOLS  
Producing formation Depth to top Bottom Total Depth of Well 2237 Feet  
Show depth and thickness of all water, oil and gas formations.

OIL, GAS OR WATER RECORDS

CASING RECORD

FORMATION	CONTENT	FROM	TO	SIZE	PUT IN	PULLED OUT
					NONE	

Describe in detail the manner in which the well was plugged, indicating where the mud fluid was placed and the method or methods used in introducing it into the hole. If cement or other plugs were used, state the character of same and depth placed, from feet to feet for each plug set.

GLOBE OILWELL CEMENTING, INC., PUMPED 135 SACKS 50/50 POZMIX 4% GEL CEMENT TO 1300'. PUMPED 65 SACKS 50/50 POZMIX, 4% GEL TO BASE OF WELL CELLAR.

RECEIVED  
STATE CORPORATION COMMISSION

JUL 17 1967

7-17-1967  
CONSERVATION DIVISION  
Wichita, Kansas

(If additional description is necessary, use BACK of this sheet)

Name of Plugging Contractor GLOBE OILWELL CEMENTING, INC.,  
Address NORTH MAIN, GREAT BEND, KANSAS

STATE OF KANSAS, COUNTY OF BARTON, ss.  
MONTE CHADD (employee of owner) or (owner or operator) of the above-described well, being first duly sworn on oath, says: That I have knowledge of the facts, statements, and matters herein contained and the log of the above-described well as filed and that the same are true and correct. So help me God. MONTE CHADD, Dist. Prod. Supt.

(Signature)

R.R. #2, GREAT BEND, KANSAS  
(Address)

14 day of JULY, 19 67

My commission expires MAY 28, 1969

Notary Public.

## WELL LOG

COMPANY Petroleum, Inc.

SEC. 32 T. 8S R. 26W

FARM Pratt

NO. 1

LOC. App NW SE

TOTAL DEPTH 2237'


COUNTY Sheridan

COMM. 6-26-67

COMP. 6-28-67

CONTRACTOR Garvey Drilling Company

CASING None

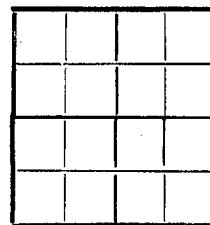

ELEVATION 2555'- KB

PRODUCTION D &amp; A

FIGURES INDICATE BOTTOM OF FORMATIONS

25' Top Soil and Sand  
 1737' Shale and Shells  
 1925' Sand  
 2150' Sand and Shale  
 2152' Shale  
 2194' Anhydrite  
 2237' Shale and Lime  
 2237' RTD

RECEIVED  
 STATE CORPORATION COMMISSION

JUL 17 1967  
 7-17-1967  
 CONSERVATION DIVISION  
 Wichita, Kansas

State of Kansas

County of Barton

SS

I, Sam N. Stephens

of

Garvey Drilling Company

upon oath state the above and foregoing is a true and correct copy of the log of the Pratt No. 1 well.

Subscribed and sworn to before me this 13th day of July 1967

My Commission Expires May 28, 1969

NOTARY PUBLIC