

WELL PLUGGING RECORD

Give All Information Completely
Make Required Affidavit
Mail or Deliver Report to:
Conservation Division
State Corporation Commission
211 No. Broadway
Wichita, Kansas

Sheridan County, Sec. 33 Twp. 8 Rge. 26 ~~NE~~ (W)

Location as "NE/CNW%SW%" or footage from lines SW NW NW

Lease Owner D. G. Hansen

Lease Name Fee D Well No. 1

Office Address Logan, Kansas

Character of Well (completed as Oil, Gas or Dry Hole) Oil

Date well completed _____ 19__

Application for plugging filed September 19 1958

Application for plugging approved September 22 1958


Plugging commenced October 2 1958

Plugging completed October 6 1958

Reason for abandonment of well or producing formation Depleted

If a producing well is abandoned, date of last production _____ 19__

Was permission obtained from the Conservation Division or its agents before plugging was commenced? Yes

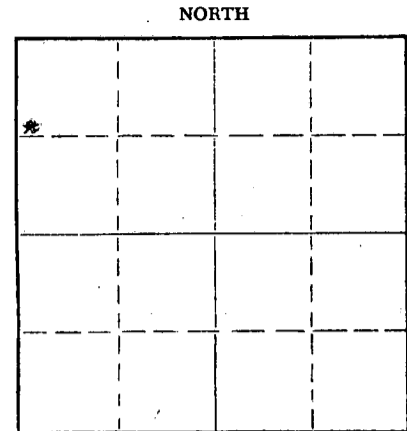

Locate well correctly on above Section Plat

Name of Conservation Agent who supervised plugging of this well A. D. Fabricius

Producing formation _____ Depth to top _____ Bottom _____ Total Depth of Well 3875 Feet

Show depth and thickness of all water, oil and gas formations.

OIL, GAS OR WATER RECORDS

CASING RECORD

FORMATION	CONTENT	FROM	TO	SIZE	PUT IN	PULLED OUT
				8 5/8"	188'	None
				5 1/2"	3873'	1613'

Describe in detail the manner in which the well was plugged, indicating where the mud fluid was placed and the method or methods used in introducing it into the hole. If cement or other plugs were used, state the character of same and depth placed, from _____ feet to _____ feet for each plug set.

Sanded hole to 3760' and dumped 4 sx. cement.
Pulled 5 1/2" casing.
Mudded to 185' and ~~XXXXXX~~, set 10' rock bridge.
Dumped 25 sx. cement. Mudded to 40' and set 10' rock bridge and dumped 10 sx. cement.

(If additional description is necessary, use BACK of this sheet)

Name of Plugging Contractor Southwest Casing Pulling Co. Inc.

Address Box 364 Great Bend, Kansas

STATE OF KANSAS, COUNTY OF BARTON, ss.


_____, (employee of owner) or (owner or operator) of the above-described well, being first duly sworn on oath, says: That I have knowledge of the facts, statements, and matters herein contained and the log of the above-described well as filed and that the same are true and correct. So help me God.

(Signature) Warren H. Hoener

(Address) _____

SUBSCRIBED AND SWORN TO before me this 11th day of October

My commission expires 2/27/60

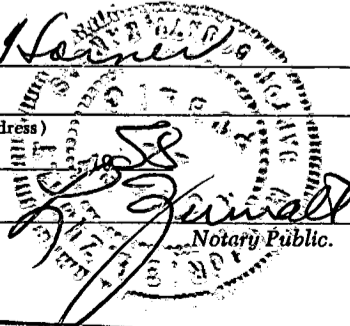

RECEIVED
STATE CORPORATION COMMISSION

OCT 14 1958
10-14-1958
CONSERVATION DIVISION
Wichita, Kansas

PLUGGING
FILE SEC 33 T. 8 R. 26W
BOOK PAGE 130 LINE 35

15-179-05166-00-00

CONTRACTOR'S WELL LOG

OPERATOR D. G. HANSEN WELL NAME FEE "D" #1

WELL LOCATION SW NW NW SEC. 33-8-26W

POOL NAME S. W. STUDLEY COUNTY SHERIDAN STATE KANSAS

COMMENCEMENT DATE July 12, 1955 COMPLETION DATE July 21, 1955

LOG OF WELL

Elevation 2522 Rotary Bushing
All measurements from the top of rotary bushing.

FROM	TO	FORMATION	DEVIATION FROM VERTICAL	REMARKS:
0	188	Shale-Sand		
188	875	Sand-Shale		
875	1410	Sand-Shale		
1410	1500	Sand		
1500	1670	Sandy Shale		
1670	1875	Sand		
1875	2112	Red Bed		
2112	2150	Anhydrite		
2150	2240	Shale & Shells		
2240	2525	Lime-Shale		
2525	2725	Lime & Shale	0° - 2750'	
2725	2925	Lime-Shale		
2925	3040	Lime-Shale	0° - 3000'	
3040	3150	Lime-Shale		
3150	3235	Lime-Shale		
3235	3365	Lime-Shale		
3365	3490	Lime-Shale		
3490	3570	Lime-Shale	0° - 3500'	
3570	3630	Lime-Shale		
3630	3648	Lime-Shale		DST 3639-3648'
3648	3670	Lime-Shale		DST 3666-3683'
3670	3683	Lime-Shale		
3683	3730	Lime-Shale		
3730	3735	Lime-Shale		DST 3720-3735'
3735	3778	Lime-Shale	0° - 3750'	
3778	3785	Lime-Shale		DST 3762-3778'
3785	3825	Lime-Shale		
3825	3835	Lime-Shale		DST 3816-3835'
3835	3875	Lime-Shale		

CASING LEFT IN HOLE AFTER COMPLETION

Set 188.13' (9 jts.) 8-5/8" OD Surface Casing. w/150 Sak Cement
STATE OF KANSAS, COUNTY OF SEDGWICK) ss. *Set 5 1/2" 14# CSG @ 3874*

The undersigned certifies that to the best of his knowledge and belief, the above facts are true and correct.

C-G DRILLING CO.

By G. F. Galloway
G. F. Galloway

Subscribed and sworn to before me this 27th day of July, 1955.

[Signature]
Notary Public

SEP 19 1955

My commission expires: March 22, 1956

PLUGGING
FILE SEC. 33T 8 R 26W
BOOK PAGE 130 LINE 35