


STATE OF KANSAS  
STATE CORPORATION COMMISSION

15-179-05167-00-00

WELL PLUGGING RECORD

Give All Information Completely  
Make Required Affidavit  
Mail or Deliver Report to:  
Conservation Division  
State Corporation Commission  
800 Bittling Building  
Wichita, Kansas

NORTH

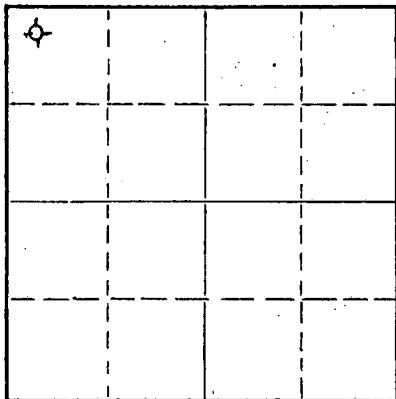

Locate well correctly on above  
Section Plat

Sheridan County. Sec. 33 Twp. 8 Rge. 26 (E) W (W)  
Location as "NE/CNW&SW" or footage from lines NW 1/4 NW 1/4 NW 1/4  
Lease Owner D. G. HANSEN  
Lease Name FEE "D" Well No. 2  
Office Address Logan, Kansas  
Character of Well (completed as Oil, Gas or Dry Hole) dry hole  
Date well completed July 31, 1955  
Application for plugging filed July 31, 1955  
Application for plugging approved July 31, 1955  
Plugging commenced July 31, 1955  
Plugging completed July 31, 1955  
Reason for abandonment of well or producing formation Too low structurally

If a producing well is abandoned, date of last production -- 19---  
Was permission obtained from the Conservation Division or its agents before plugging was commenced? Yes

Name of Conservation Agent who supervised plugging of this well Eldon Petty, Hays, Kansas  
Producing formation \_\_\_\_\_ Depth to top \_\_\_\_\_ Bottom \_\_\_\_\_ Total Depth of Well \_\_\_\_\_ Feet  
Show depth and thickness of all water, oil and gas formations.

OIL, GAS OR WATER RECORDS

CASING RECORD

FORMATION	CONTENT	FROM	TO	SIZE	PUT IN	PULLED OUT
				8-5/8"	185.84'	none

Describe in detail the manner in which the well was plugged, indicating where the mud fluid was placed and the method or methods used in introducing it into the hole. If cement or other plugs were used, state the character of same and depth placed, from \_\_\_\_\_ feet to \_\_\_\_\_ feet for each plug set.

Filled hole with heavy mud to 180'. Set solid plug.  
Put in 1/2 sack hulls and 15 sacks cement. Set plug at 40'. Filled hole to top with 1/2 sack hulls and 10 sacks cement.

(If additional description is necessary, use BACK of this sheet)

Name of Plugging Contractor C-G DRILLING CO  
Address 107 Rule Building, Wichita, Kansas

STATE OF KANSAS, COUNTY OF SEDGWICK, ss.  
G. F. Galloway (employee of owner) or ~~(owner or operator)~~ of the above-described well, being first duly sworn on oath, says: That I have knowledge of the facts, statements, and matters herein contained and the log of the above-described well as filed and that the same are true and correct. So help me God.

(Signature) G. F. Galloway  
107 Rule Building, Wichita, Kansas  
(Address)

SUBSCRIBED AND SWORN to before me this 1st day of August, 1955  
My Commission Expires May 20, 1959



Ricky Jacobs  
**RECEIVED**  
STATE CORPORATION COMMISSION  
AUG 4 X 1955  
CONSERVATION DIVISION  
Wichita, Kansas

**PLUGGING**  
FILE SEC. 33 T. 8 R. 26 W  
BOOK PAGE 140 LINE 1

15-179-05167-00-00

CONTRACTOR'S WELL LOG

OPERATOR D. G. HANSEN WELL NAME FEE "D" #2  
WELL LOCATION NW NW NW Sec. 33-8-26W  
POOL NAME STUDLEY COUNTY SHERIDAN STATE KANSAS  
COMMENCEMENT DATE JULY 22, 1955 COMPLETION DATE JULY 31, 1955

LOG OF WELL

Elevation 2484 Rotary Bushing.  
All measurements from the top of rotary bushing.

FROM	TO	FORMATION	DEVIATION FROM VERTICAL	REMARKS:
0	70	Shale-Sand		
70	185	Shale-Sand		
185	1000	Shale		
1000	1370	Shale-Sand		
1370	1440	Sand		
1440	1665	Shale		
1665	1690	Shale		
1690	1865	Sand		
1865	2050	Sand & Red Bed		
2050	2084	Red Bed		
2084	2124	Anhydrite		
2124	2330	Shale-Lime		
2330	2490	Shale-Shells		
2490	2660	Lime-Shale		
2660	2850	Lime-Shale	0° - 2750'	
2850	2970	Lime-Shale		
2970	3070	Lime-Shale	0° - 3000'	
3070	3140	Lime-Shale		
3140	3240	Lime-Shale		
3240	3370	Lime-Shale		
3370	3475	Lime-Shale		
3475	3535	Shale-Lime	0° - 3500'	
3535	3615	Lime-Shale		
3615	3648	Lime-Shale		
3648	3700	Lime-Shale		
3700	3742	Lime-Shale		
3742	3760	Lime-Shale	0 - 3750'	DST 3727-3742'.
3760	3800	Lime-Shale		
3800	3835	Lime		DST 3790-3800'
3835	3850	Lime		Ran Electric Log.

CASING LEFT IN HOLE AFTER COMPLETION

Set 185.84' ( 9 jts.) 8-5/8" OD Surface Casing.

STATE OF KANSAS, COUNTY OF SEDGWICK ) ss.

The undersigned certifies that to the best of his knowledge and belief, the above facts are true and correct.

RECEIVED  
STATE CORPORATION COMMISSION

AUG 4 X 1955

C-G DRILLING CO.

By G. F. Galloway  
G. F. Galloway

Subscribed and sworn to before me this 2nd day of August, 1955.

Wichita, Kansas

Wicky Jacobs  
Notary Public

My commission expires: May 20, 1959

PLUGGING  
PAGE SEC 33 T 8 R 26 W  
BOOK PAGE 140 LINE 1

