


Give All Information Completely
Make Required Affidavit
Mail or Deliver Report to:
Conservation Division
State Corporation Commission
211 No. Broadway
Wichita, Kansas

WELL PLUGGING RECORD

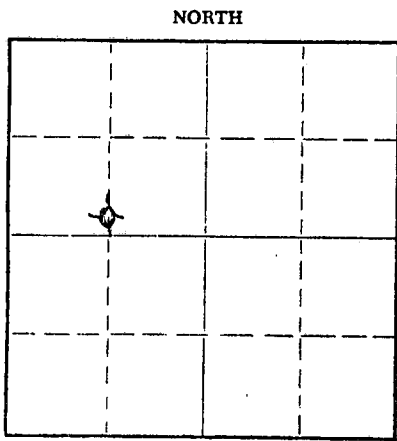

Locate well correctly on above Section Plat

SHERIDAN County. Sec. 33 Twp. 8 Rge. 26 (E) W (W)
Location as "NE/CNWxSWx" or footage from lines APPX. CENTER S₁/₂ S₂ NW₁/₂
Lease Owner DANE G HANSEN TR
Lease Name FEES#4 "D" Hansen Fee D KCC ZAP Well No. 4
Office Address LOGAN, KANSAS
Character of Well (completed as Oil, Gas or Dry Hole) DRY HOLE
Date well completed JUNE 14, 1967 19
Application for plugging filed JUNE 14, 1967 19
Application for plugging approved JUNE 14, 1967 19
Plugging commenced JUNE 14, 1967 19
Plugging completed JUNE 14, 1967 19
Reason for abandonment of well or producing formation TOO LOW STRUCTURALLY

If a producing well is abandoned, date of last production _____ 19____
Was permission obtained from the Conservation Division or its agents before plugging was commenced? YES

Name of Conservation Agent who supervised plugging of this well W. L. NICHOLS, MORELAND, KANSAS
Producing formation _____ Depth to top _____ Bottom _____ Total Depth of Well 3850' Feet
Show depth and thickness of all water, oil and gas formations.

OIL, GAS OR WATER RECORDS

CASING RECORD

FORMATION	CONTENT	FROM	TO	SIZE	PUT IN	PULLED OUT
				8-5/8"	186.07'	NONE

Describe in detail the manner in which the well was plugged, indicating where the mud fluid was placed and the method or methods used in introducing it into the hole. If cement or other plugs were used, state the character of same and depth placed, from _____ feet to _____ feet for each plug set.

FOOLED WITH HEAVY MUD TO 550'. SET PLUG. PUT IN 25 SACKS CEMENT. FILLED WITH HEAVY MUD TO 180'. SET PLUG. PUT IN 25 SACKS CEMENT. FILLED WITH HEAVY MUD TO 40'. SET PLUG. FILLED TO TOP WITH 10 SACKS CEMENT.

RECEIVED
STATE CORPORATION COMMISSION
JUN 28 1967
06-28-1967
CONSERVATION DIVISION
Wichita, Kansas

Name of Plugging Contractor _____
Address _____
(If additional description is necessary, use BACK of this sheet)


STATE OF KANSAS COUNTY OF SEDGWICK, ss.
G F GALLOWAY

(employee of owner) or ~~X~~ of the above-described well, being first duly sworn on oath, says: That I have knowledge of the facts, statements, and matters herein contained and the log of the above-described well as filed and that the same are true and correct. So help me God.

(Signature) G. F. Galloway
G. F. GALLOWAY
107 RULE BUILDING
(Address)

SUBSCRIBED AND SWORN to before me this 19th day of JUNE, 19 67

My commission expires JAN 23, 1968
Phyllis McJinsey
PHYLLIS McJINSEY Notary Public.

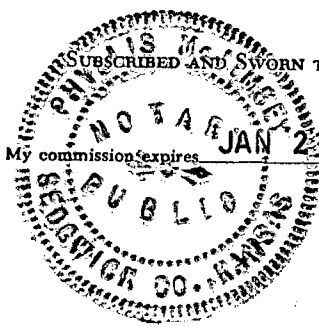

15-179-20016-00-00

WELL LOG

OPERATOR: DANE G HANSEN TR
WELL NAME: Hansen Fee D 4 KCC 2AP FEE #4 D LOCATION: SEC 33-8-26W
APPX. CENTER S $\frac{1}{2}$ S $\frac{1}{2}$ NW $\frac{1}{4}$
COUNTY: SHERIDAN STATE: KANSAS
WELL COMMENCED: JUNE 6, 1967 WELL COMPLETED: JUNE 14, 1967
ELEVATION: 2503 KB TOTAL DEPTH: 3850'
PRODUCTION: DRY & ABANDONED RIG NO: 1
CASING - 8-5/8": (9 jts) 186.07' W/150 SX + 2 SX CA. CL.
5-1/2": _____

All Measurements taken from the top of rotary bushing.

FROM	TO	FORMATION	DEVIATION FROM VERTICAL		REMARKS:
186	1690	SHALE	525'	$\frac{1}{2}^{\circ}$	
1689	1890	SAND	1000	$\frac{1}{2}^{\circ}$	
1890	2040	RED BED & SHALE	1500	$3/4^{\circ}$	
2040	2091	SHALE	2000	1°	DST #1 3593-3635
2091	2126	ANHYDRITE	2500	1°	DST #2 3640-3666
2126	2450	SHALE & SHELLS	3000	$3/4^{\circ}$	DST #3 3665-3686
2450	3050	SHALE & LIME	3635	$\frac{1}{2}^{\circ}$	DST #4 3685-3735
3050	3160	LIME			DST #5 3739-3765
3160	3285	LIME & SHALE			DST #6 3778-3850
3625	3635	LIME			
3635	3666	LIME & SHALE			
3666	3850	LIME			

RECEIVED
STATE CORPORATION COMMISSION
JUN 28 1967
CONSERVATION DIVISION
Wichita, Kansas


STATE OF KANSAS
COUNTY OF SEDGWICK) SS:

The undersigned hereby certifies that to the best of his knowledge and belief, the above facts are true and correct.

C-G DRILLING CO.

By G. F. Galloway
G. F. GALLOWAY

SUBSCRIBED AND SWORN TO, BEFORE ME, This 19th day of JUNE, 1967.

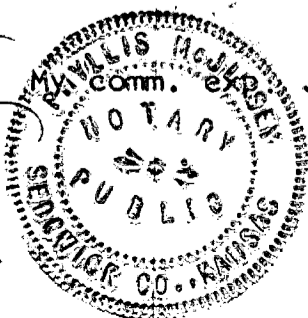

Jan. 23, 1968

Phyllis McJimsey
Phyllis McJimsey --- Notary Public