

STATE OF KANSAS  
STATE CORPORATION COMMISSION

WELL PLUGGING RECORD

Give All Information Completely  
Make Required Affidavit  
Mail or Deliver Report to  
Conservation Division  
State Corporation Comm.  
245 North Water  
Wichita, KS 67202

Sheridan County, Sec. 34 Twp. 8S Rge. 26W E/W  
Location as "NE/CNW 1/4 SW 1/4" or footage from lines \_\_\_\_\_

SE SW NE

Lease Owner John Jay Darrah, Jr.

Lease Name Pratt Well No. 1

Office Address 1010 Century Plaza, Wichita, Kansas

Character of Well (Completed as Oil, Gas or Dry Hole) \_\_\_\_\_

Dry Hole

Date Well completed December 9, 1979

Application for plugging filed December 9, 1979

Application for plugging approved December 9, 1979

Plugging commenced December 9, 1979


Plugging completed December 9, 1979

Reason for abandonment of well or producing formation \_\_\_\_\_

Dry Hole

If a producing well is abandoned, date of last production \_\_\_\_\_ 19\_\_\_\_

Was permission obtained from the Conservation Division or its agents before plugging was commenced? Yes

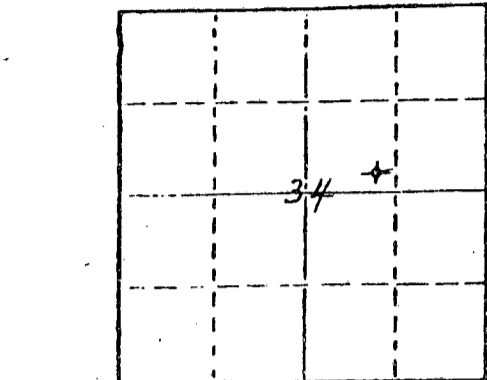

Locate well correctly on above Section Plat

Name of Conservation Agent who supervised plugging of this well Gil Balthazor

Producing formation \_\_\_\_\_ Depth to top \_\_\_\_\_ Bottom \_\_\_\_\_ Total Depth of Well 4008'

Show depth and thickness of all water, oil and gas formations.

OIL, GAS OR WATER RECORDS

CASING RECORD

FORMATION	CONTENT	FROM	TO	SIZE	PUT IN	PULLED OUT
		0'	274'	8-5/8"	267.06'	None

Describe in detail the manner in which the well was plugged, indicating where the mud fluid was placed and the method or methods used in introducing it into the hold. If cement or other plugs were used, state the character of same and depth placed, from \_\_\_\_\_ feet to \_\_\_\_\_ feet for each plug set.

Plugged with 70 sacks cement at 1000',  
25 sacks cement at 270', 10 sacks cement  
and plug at 40' (50-50 Pozmix, 6% Gel).

(If additional description is necessary, use BACK of this sheet)

Name of Plugging Contractor Allied Cementing Co.


STATE OF KANSAS COUNTY OF SEDGWICK, ss.

John D. Knightley Agent (employee of owner) or (owner or operator)

of the above-described well, being first duly sworn on oath, says: That I have knowledge of the facts, statements, and matters herein contained and the log of the above-described well as filed and that the same are true and correct. So help me God.

(Signature) [Signature]  
221 S. Broadway, Wichita, Kansas  
(Address)

SUBSCRIBED AND SWORN TO before me this 26th day of December, 1979

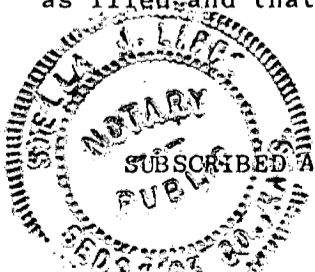

Stella J. Lipps  
Notary Public.

My commission expires March 12, 1983

RECEIVED  
STATE CORPORATION COMMISSION

DEC 27 1979  
12-27-1979  
CONSERVATION DIVISION  
Wichita, Kansas

John Jay Darrah, Jr.  
1010 Century Plaza  
Wichita, Kansas 67202

Pratt #1  
SE SW NE Sec. 34-8S-26W  
Sheridan County, Kansas

Contractor: D. R. Lauck Oil Company, Inc.  
221 S. Broadway, Suite 400  
Wichita, Kansas 67202

Commenced: December 4, 1979  
Completed: December 9, 1979

Drillers Log

Sand & Shale	280
Shale	1215
Shale & Shells	1835
Sand	1985
Shale & Shells	2545
Shale & Lime	2790
Shale & Shells	3200
Shale & Lime	3955
Lime	4008 RTD

RECEIVED  
STATE CORPORATION COMMISSION

DEC 27 1979  
12-27-1979  
CONSERVATION DIVISION  
Wichita, Kansas