

15-179-30068-00-00

STATE OF KANSAS
STATE CORPORATION COMMISSION

Form CP-4


Give All Information Completely
Make Required Affidavit
Mail or Deliver Report to:
Conservation Division
State Corporation Commission
212 No. Market
Wichita, Kansas

WELL PLUGGING RECORD

Sheridan County, Sec. 35 Twp. 8S Rge. 26 (E) W (W)

Location as "NE/CNW/SW" or footage from lines SE SE SW
Lease Owner Halliburton Oil Producing Company
Lease Name Sanger # 1 Well No. 1
Office Address Cameron Bldg., 2915 Classen Blvd., Oklahoma City, Okla.
Character of Well (completed as Oil, Gas or Dry Hole) Dry Hole
Date well completed January 16 19 66
Application for plugging filed January 16 19 66
Application for plugging approved January 16 19 66
Plugging commenced January 16 5:30 P.M. 19 66
Plugging completed January 16 8:00 P.M. 19 66
Reason for abandonment of well or producing formation Dry Hole

NORTH

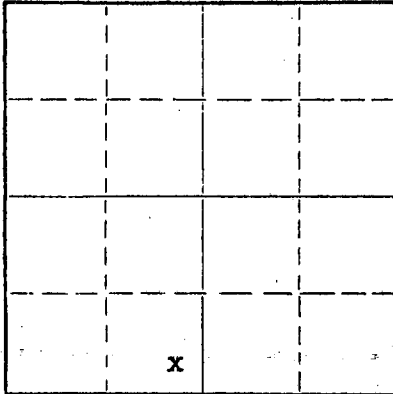

Locate well correctly on above
Section Plat

If a producing well is abandoned, date of last production 19
Was permission obtained from the Conservation Division or its agents before plugging was com-
menced? Yes

Name of Conservation Agent who supervised plugging of this well W. L. Nichols, Morland, Kansas
Producing formation Depth to top Bottom Total Depth of Well 3990 Feet
Show depth and thickness of all water, oil and gas formations.

OIL, GAS OR WATER RECORDS

CASING RECORD

FORMATION	CONTENT	FROM	TO	SIZE	PUT IN	PULLED OUT
		0	260	7"	260	0

Describe in detail the manner in which the well was plugged, indicating where the mud fluid was placed and the method or methods used in introducing it into the hole. If cement or other plugs were used, state the character of same and depth placed, from feet to feet for each plug set.

Plugged with 15 sx cement @ 540 ft., 15 sx cement @ 250 ft.,
10 sx cement @ 40 ft. to surface.

RECEIVED
STATE CORPORATION COMMISSION


JAN 21 1966
01-21-1966
CONSERVATION DIV.
WICHITA, KANSAS

(If additional description is necessary, use BACK of this sheet)
Name of Plugging Contractor Paine Drilling Co., Inc.
Address P. O. Box D, Hill City, Kansas

STATE OF Kansas, COUNTY OF Graham, ss.
D. F. McCarthy (employee of ~~owner~~ operator) of the above-described well, being first duly sworn on oath, says: That I have knowledge of the facts, statements, and matters herein contained and the log of the above-described well as filed and that the same are true and correct. So help me, God.

(Signature) D. F. McCarthy
P. O. Box D, Hill City, Kansas
(Address)

SUBSCRIBED AND SWORN TO before me this 19th day of January, 1966
Commission Expires January 20, 1968
My commission expires
Notary Public.

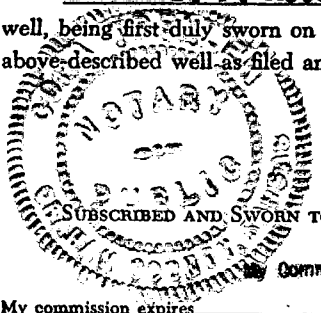

15-179-30068-00-00

CONTRACTOR'S WELL LOG

COMPANY:	Halliburton Oil Producing Company
CONTRACTOR:	Paine Drilling Co., Inc.
WELL:	Sanger # 1
LOCATION:	SE SE SW Section 35-8S-26W Sheridan County, Kansas
COMMENCED:	January 7, 1966
COMPLETED:	January 16, 1966

0	180	Clay & Sand
180	260	Blue Shale
260	1804	Shale
1804	1980	Sand
1980	2205	Shale
2205	2243	Anhydrite
2243	2890	Shale
2890	3755	Shale & Lime
3755	3790	Lime
3790	3804	Lime & Shale
3804	3870	Lime
3870	3990	Lime & Shale
3990		Rotary Total Depth

RECEIVED
SHERIDAN COUNTY, KANSAS

JAN 21 1966

RECEIVED
SHERIDAN COUNTY, KANSAS

Set 7-inch Surface Casing @ 260' with 160 sx cement.

Dry & Abandoned

We hereby certify that the above is a correct and accurate log of the above mentioned well, as shown on the daily drilling reports.

PAINE DRILLING CO., INC.

BY: D. F. McCarthy

Subscribed and sworn to before me this 18th day of January, 1966.

My Commission Expires January 20, 1968

Caro Duffer
Notary Public