


Give All Information Completely
Make Required Affidavit
Mail or Deliver Report to:
Conservation Division
State Corporation Commission
212 North Market, Insurance Bldg.
Wichita, Kansas

WELL PLUGGING RECORD

NORTH

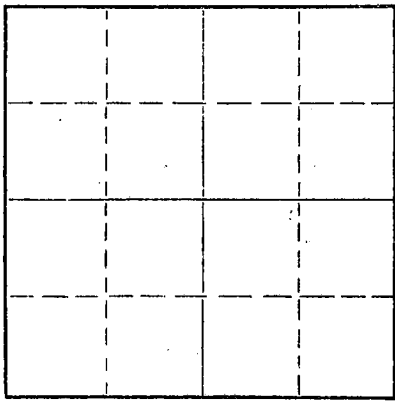

Locate well correctly on above
Section Plat

Sheridan County, Sec. 34 Twp. 8S Rge. 27W (W)
Location as "NE/CNW/SW" or footage from lines. GEN NW 1/4 NW 1/4
Lease Owner Aurora Gasoline Co.
Lease Name Mosier #1 Well No. 1
Office Address 1107 Union National Bldg., Wichita, Kans.
Character of Well (completed as Oil, Gas or Dry Hole) Dry Hole
Date well completed 3-19-59 19
Application for plugging filed 3-19-59 19
Application for plugging approved 3-19-59 19
Plugging commenced 3-19-59 19
Plugging completed 3-19-59 19
Reason for abandonment of well or producing formation Dry Hole

If a producing well is abandoned, date of last production --- 19
Was permission obtained from the Conservation Division or its agents before plugging was commenced? yes

Name of Conservation Agent who supervised plugging of this well A. D. Fabricius
Producing formation _____ Depth to top _____ Bottom _____ Total Depth of Well 4365 Feet
Show depth and thickness of all water, oil and gas formations.

OIL, GAS OR WATER RECORDS

CASING RECORD

FORMATION	CONTENT	FROM	TO	SIZE	PUT IN	PULLED OUT
				8 5/8	228'	

Describe in detail the manner in which the well was plugged, indicating where the mud fluid was placed and the method or methods used in introducing it into the hole. If cement or other plugs were used, state the character of same and depth placed, from _____ feet to _____ feet for each plug set.

1st plug @ 600' with 20 sacks cement.
2nd plug @ 230' with 20 sacks cement.
Top plug @ 40' with 10 sacks cement & 1/2 sack hulls.

RECEIVED
STATE CORPORATION COMMISSION
MAR 27 1959
CONSERVATION DIVISION
Wichita, Kansas

327-59

(If additional description is necessary, use BACK of this sheet)

Name of Plugging Contractor Leben Drilling, Inc.
Address 905 Central Bldg., Wichita, Kansas

STATE OF Kansas, COUNTY OF Sedgwick, ss.
I, Frank Hamlin (employee of ~~owner~~ Contractor) of the above-described well, being first duly sworn on oath, says: That I have knowledge of the facts, statements, and matters herein contained and the log of the above-described well as filed and that the same are true and correct. So help me God.

(Signature) Frank Hamlin
905 Central Bldg., Wichita, Kansas
(Address)

SUBSCRIBED AND SWORN TO before me this 26th day of March, 19 59

Ruth N. Benjamin
Notary Public.

My commission expires June 17, 1961

PLUGGING
FILE SEC. 34 T. 8 R. 27W
BOOK PAGE 26 LINE 3

DRILLER'S LOG

COMPANY:
CONTRACTOR:
WELL:
LOCATION:
COMPLETED:
COMPLETED:

AURORA GASOLINE COMPANY
LEWIS DRILLING, INC.
WELL #1
CEN 1/4 1/4 SEC. 9-63-27
SHERIDAN COUNTY, KANSAS
3-7-59
3-19-59

0	135	Sand & Shale	100 FEET:	
135	235	Blue Shale	Anhydrite	2230
235	1300	Shale & Sand	Topok	2471
1300	1535	Sand	Hoebner	3740
1535	1950	Shale & Shale	Toronto	3767
1950	2230	Red bed & Shale	Landing	3781
2230	2270	Anhydrite	Es. R. C.	3997
2270	3795	Shale & Lms	Horton	4311
3795	3960	Lms	Lms.	4335
3960	4305	Lms & Shale	HTD	4365
4305	4314	Shale & Sand		
4314	4316	Conglomerate		
4316	4365	Unconformity		
4365	4335	Rotary Total Depth - D & A		

Elevation 2588 R. D.

Box B 5/8" casing ending 0 228" with 165 casing cement.

I, Frank Hamlin, do hereby certify that the above and foregoing is a true and correct copy of the log of the well #1, located CEN 1/4 1/4 of Section 34, Township 8 South, Range 27 West, Sheridan County, Kansas, as reflected by the files of Lewis Drilling, Inc.

LEWIS DRILLING, INC.

By Frank Hamlin
Frank Hamlin

STATE OF KANSAS)
COUNTY OF SEDWICK) SS

Subscribed and sworn to before me, a Notary Public, in and for Sedwick County, Kansas, this 25th day of March, 1959.

Earl H. Majors
Earl H. Majors, Notary Public

By Commission Expires
June 17, 1961

RECEIVED
STATE CORPORATION COMMISSION

MAR 27 1959 3-27-59
DIVISION

PLUGGING
FILE SEC. 34 T. 8 R. 27W
BOOK PAGE 26 LINE 3