

15-179-20521-00-00


STATE OF KANSAS
STATE CORPORATION COMMISSION

Form CP-4

Give All Information Completely
Make Required Affidavit
Mail or Deliver Report to:
Conservation Division
State Corporation Commission
P. O. Box 17027
Wichita, Kansas 67217
NORTH

WELL PLUGGING RECORD

Sheridan County, Sec. 34 Twp. 8 Rge. 27W (E) (W)
Location as "NE/CNW%SW%" or footage from lines. SWSE SW
Lease Owner. Donald C. Slawson
Lease Name Mosier 'N' Well No. 2
Office Address 200 Douglas Building Wichita, Kansas 67202
Character of Well (completed as Oil, Gas or Dry Hole) Dry Hole
Date well completed October 29, 1978
Application for plugging filed October 29, 1978
Application for plugging approved October 29, 1978
Plugging commenced October 29, 1978
Plugging completed October 29, 1978
Reason for abandonment of well or producing formation Dry Hole

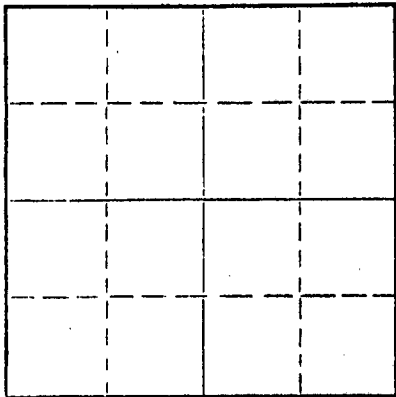

Locate well correctly on above Section Plat

If a producing well is abandoned, date of last production 19
Was permission obtained from the Conservation Division or its agents before plugging was commenced? yes

Name of Conservation Agent who supervised plugging of this well Gilbert Balthazor
Producing formation Depth to top Bottom Total Depth of Well 3957' Feet
Show depth and thickness of all water, oil and gas formations.

OIL, GAS OR WATER RECORDS

CASING RECORD

FORMATION	CONTENT	FROM	TO	SIZE	PUT IN	PULLED OUT
	274.95'	surface	270'	8 5/8"		

Describe in detail the manner in which the well was plugged, indicating where the mud fluid was placed and the method or methods used in introducing it into the hole. If cement or other plugs were used, state the character of same and depth placed, from feet to feet for each plug set.

1st plug @ 1200' w/70 sx
2nd plug @ 240' w/20 sx
Top plug @ 40' w/10 sx
2 sx in rat hole

RECEIVED
STATE CORPORATION COMMISSION

DEC 29 1978

CONSERVATION DIVISION
Wichita, Kansas

12-29-78


(If additional description is necessary, use BACK of this sheet)
Name of Plugging Contractor Slawson Drilling Co., Inc.
Address 200 Douglas Building Wichita, Kansas 67202

STATE OF KANSAS, COUNTY OF SEDGWICK, ss.
R.J. THATCHER (employee of owner) or (owner or operator) of the above-described well, being first duly sworn on oath, says: That I have knowledge of the facts, statements, and matters herein contained and the log of the above-described well as filed and that the same are true and correct. So help me God.

(Signature) R.J. Thatcher
R.J. THATCHER 200 Douglas Bldg., Wichita, Ks
(Address)

SUBSCRIBED AND SWORN TO before me this 15th day of December, 1978

My commission expires 6/12/82 Sherry Milford Notary Public.

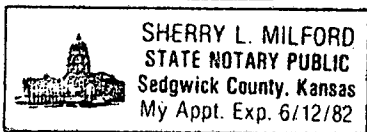

WELL LOG

15-179-20521-00-00

OPERATOR: Donald C. Slawson
200 Douglas Building
Wichita, Kansas 67202

LEASE: #2 Mosier 'N'
SW SE SW of Sec. 34-8-27W
Sheridan County, Kansas

CONTRACTOR: Slawson Drilling Co., Inc.
200 Douglas Building
Wichita, Kansas 67202

COMMENCED: October 21, 1978

COMPLETED: October 29, 1978

CASING: Surface - 8 5/8" @ 270' w/175 sx 60/40 poz .

0 - 276	Surface hole
276 - 2216	Shale and shells
2216 - 2249	Anhydrite
2249 - 2899	Shale
2899 - 3791	Lime and shale
3791 - 3957	Lime
3957	RTD

RECEIVED
STATE CORPORATION COMMISSION

DEC 29 1978
12-29-78
CONSERVATION DIVISION
Wichita, Kansas

STATE OF KANSAS)
)
COUNTY OF SEDGWICK) SS.

I, R.J. THATCHER, of the Slawson Drilling Co., Inc. upon oath state that the above and foregoing is a true and correct copy of the log of the #2 Mosier 'N' test

R.J. Thatcher

R.J. THATCHER

Subscribed and sworn to before me this 15th day of December, 1978.

Sherry L. Milford

SHERRY MILFORD, Notary Public

My Commission Expires: 6/12/82

