

TYPE

AFFIDAVIT OF COMPLETION FORM

ACO-1 WELL HISTORY

SIDE ONE

Two (2) copies of this form shall be filed with the Kansas Corporation Commission, 200 Colorado Derby Building, Wichita, Kansas 67202, within thirty (30) days after the completion of a well, regardless of how the well was completed.

Attach separate letter of request if the information is to be held confidential. If confidential, only file one copy. Information on Side One will be of public record and Side Two will then be held confidential.

Applications must be made on dual completion, commingling, salt water disposal, injection and temporarily abandoned wells.

Attach one copy only wireline logs (i.e. electrical log, sonic log, gamma ray neutron log, etc.). (Rules 82-2-105 & 82-2-125) KCC# (316) 263-3238.

LICENSE # 5005 EXPIRATION DATE 6-30-83
OPERATOR Sunburst Exploration Company, Inc. API NO. 15-179-20,680
ADDRESS 708 One Main Place COUNTY Sheridan
Wichita, KS 67202 FIELD Wildcat
\*\* CONTACT PERSON Ronald L. Irion PROD. FORMATION
PHONE (316) 262-3041
PURCHASER LEASE Summerson
ADDRESS WELL NO. #1
WELL LOCATION NW NE NE
330 Ft. from the north Line and
990 Ft. from the east Line of
the NE/4(Qtr.) SEC 31 TWP 8S RGE 29W.

PLUGGING Sun Oil Well Cementing, Inc
CONTRACTOR
ADDRESS Box 169
Great Bend, Kansas 67530


TOTAL DEPTH 4560' PBD
SPUD DATE 5-9-83 DATE COMPLETED 5-20-83
ELEV: GR 2805' DF 2808' KB 2810'

DRILLED WITH (XXX) (ROTARY) (XXX) TOOLS.
DOCKET NO. OF DISPOSAL OR REPRESSURING WELL BEING
USED TO DISPOSE OF WATER FROM THIS LEASE

Amount of surface pipe set and cemented 392' DV Tool Used? No

THIS AFFIDAVIT APPLIES TO: (Circle ONE) - Oil, Gas, Shut-in Gas, Dry, Disposal, Injection, Temporarily Abandoned, OWWO. Other

ALL REQUIREMENTS OF THE STATUTES, RULES AND REGULATIONS PROMULGATED TO REGULATE THE OIL AND GAS INDUSTRY HAVE BEEN FULLY COMPLIED WITH.

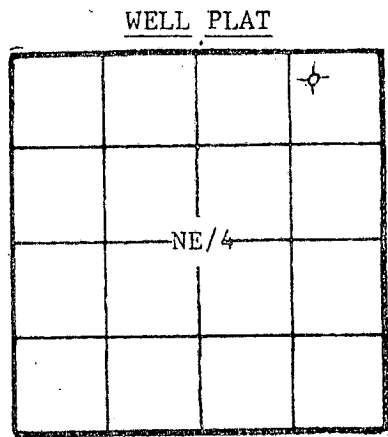

(Office Use Only)
KCC [check]
KGS [check]
SWD/REP
PLG.

A F F I D A V I T

Ronald L. Irion, being of lawful age, hereby certifies that:


I am the Affiant, and I am familiar with the contents of the foregoing Affidavit. The statements and allegations contained therein are true and correct.

Ronald L. Irion (Name)

SUBSCRIBED AND SWORN TO BEFORE ME this 26th day of May, 1983.

MY COMMISSION EXPIRES: July 23, 1985 Julie K. Polczynski (NOTARY PUBLIC)

\*\* The person who can be reached by phone regarding any questions concerning this information.

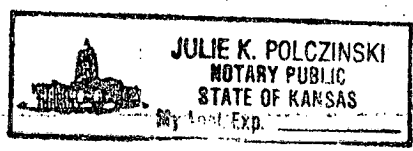

RECEIVED STATE CORPORATION COMMISSION
MAY 27 1983
5-27-83
CONSERVATION DIVISION
Wichita, Kansas