

15-179-20308-00-00

STATE OF KANSAS  
STATE CORPORATION COMMISSION

Form CP-4


Give All Information Completely  
Make Required Affidavit  
Mail or Deliver Report to:  
Conservation Division  
State Corporation Commission  
P. O. Box 17027  
Wichita, Kansas 67217  
NORTH

WELL PLUGGING RECORD

SHERIDAN

County. Sec. 35 Twp. 8S Rge. 29W (E) (W)

Location as "NE/CNW/SW" or footage from lines SW/4 NE/4  
Lease Owner PETROLEUM RESERVE CORPORATION  
Lease Name #1 Hughes Well No. #1  
Office Address 225 Cravens Bldg, Okla. City, Okla. 73102  
Character of Well (completed as Oil, Gas or Dry Hole) Dry Hole  
Date well completed 7/12/72 19 72  
Application for plugging filed 19 72  
Application for plugging approved 19 72  
Plugging commenced July 13, 19 72  
Plugging completed July 13, 19 72  
Reason for abandonment of well or producing formation \_\_\_\_\_

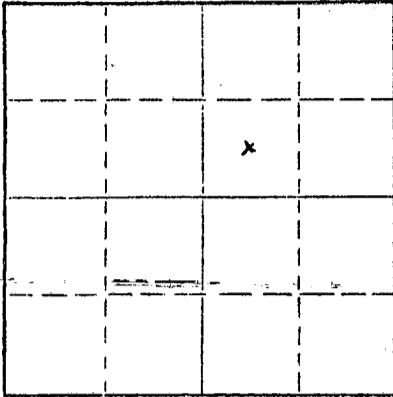

Locate well correctly on above Section Plat

If a producing well is abandoned, date of last production \_\_\_\_\_ 19 \_\_\_\_\_  
Was permission obtained from the Conservation Division or its agents before plugging was commenced? Yes

Name of Conservation Agent who supervised plugging of this well Mr. Leo Massey, Hays, Kansas  
Producing formation None Depth to top \_\_\_\_\_ Bottom \_\_\_\_\_ Total Depth of Well 4180' Feet  
Show depth and thickness of all water, oil and gas formations.

OIL, GAS OR WATER RECORDS

CASING RECORD

FORMATION	CONTENT	FROM	TO	SIZE	PUT IN	PULLED OUT
			240'	of 8-5/8" W/Landing Joint		
				Cmt. circ. to surface.		

Describe in detail the manner in which the well was plugged, indicating where the mud fluid was placed and the method or methods used in introducing it into the hole. If cement or other plugs were used, state the character of same and depth placed, from \_\_\_\_\_ feet to \_\_\_\_\_ feet for each plug set.

Heavy Mud From 4180' to 1450'.  
70Sx Cmt. Plug. Heavy Mud to 225'. Plug W/20 Sx. Cmt.  
Mud to 40'. Plug bridged & 10Sx. Cmt. to base of cellar.  
2SX. in Rat-hole. Job Complete 12:00 PM

RECEIVED  
STATE CORPORATION COMMISSION  
JUL 17 1972  
7/17/72  
CONSERVATION DIVISION  
Wichita, Kansas

(If additional description is necessary, use BACK of this sheet)


Name of Plugging Contractor Sage Drilling Company  
Address 500 Bitting Bldg., Wichita, Kansas

STATE OF Oklahoma, COUNTY OF Oklahoma, ss.  
LAWRENCE E. WILSEY (employee of owner) or (owner or operator) of the above-described well, being first duly sworn on oath, says: That I have knowledge of the facts, statements, and matters herein contained and the log of the above-described well as filed and that the same are true and correct. So help me God.

(Signature) Lawrence E. Wilsey  
225 Cravens Bldg, Okla. City, Okla. 73102  
(Address)

SUBSCRIBED AND SWORN to before me this 14th. day of July, 19 72

My commission expires \_\_\_\_\_

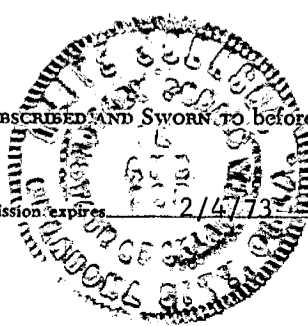

Olive Johnson  
Notary Public.