


Give All Information Completely
Make Required Affidavit
Mail or Deliver Report to:
Conservation Division
State Corporation Commission
212 No. Market
Wichita, Kansas

15-179-20308-5000

WELL PLUGGING RECORD

NORTH

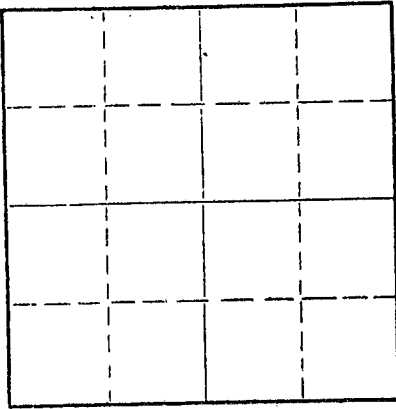

Locate well correctly on above
Section Plat

Sheridan County. Sec. 35 Twp. 8S Rge. (E) 29 (W)
Location as "NE/CNW/SW" or footage from lines. App. SW NE
Lease Owner Petroleum Reserve Corporation
Lease Name Hughes Well No. 1
Office Address Cravens Building, Okla. City, Okla. 73102
Character of Well (completed as Oil, Gas or Dry Hole) Dry Hole
Date well completed July 13 19 72
Application for plugging filed 19
Application for plugging approved July 13 19
Plugging commenced July 13 19 72
Plugging completed July 13 19 72
Reason for abandonment of well or producing formation Dry Hole

If a producing well is abandoned, date of last production 19
Was permission obtained from the Conservation Division or its agents before plugging was commenced? Yes (Loe Massey of Hays)

Name of Conservation Agent who supervised plugging of this well
Producing formation Depth to top Bottom Total Depth of Well 4180 Feet
Show depth and thickness of all water, oil and gas formations.

OIL, GAS OR WATER RECORDS

CASING RECORD

FORMATION	CONTENT	FROM	TO	SIZE	PUT IN	PULLED OUT
	Surface	0	246'	8-5/8"	246'	None
	Casing					

Describe in detail the manner in which the well was plugged, indicating where the mud fluid was placed and the method or methods used in introducing it into the hole. If cement or other plugs were used, state the character of same and depth placed, from feet to feet for each plug set.

Heavy Mud from Total Depth to 1450' Feet,
70 sax Cement; Mud to 225 Feet, plug and
20 sax Cement; Mud to 40', Plug Bridged
and 10 sax Cement to Base of Cellar;
2 sax Cement in Rat Hole. Job Completed
at Midnight.

RECEIVED
STATE CORPORATION COMMISSION
JUL 21 1972
CONSERVATION DIVISION
Wichita, Kansas

(If additional description is necessary, use BACK of this sheet)

Name of Plugging Contractor Sun Cement Company
Address

STATE OF KANSAS, COUNTY OF SEDGWICK, SS.
Clarence Michael of Sage Drilling Co (employee of owner) or (owner or operator) of the above-described well, being first duly sworn on oath, says: That I have knowledge of the facts, statements, and matters herein contained and the log of the above-described well as filed and that the same are true and correct. So help me God.

(Signature) Clarence Michael
500 Bitting Building, Wichita, Kansas
(Address)

SUBSCRIBED AND SWORN to before me this 19th day of July 19 72



Marjorie H. McFadden
Notary Public.

- 6 - 75 -