


15-193-20084-00-00

STATE OF KANSAS  
STATE CORPORATION COMMISSION  
CONSERVATION DIVISION  
P. O. BOX 17027  
WICHITA, KANSAS 67217

WELL PLUGGING RECORD

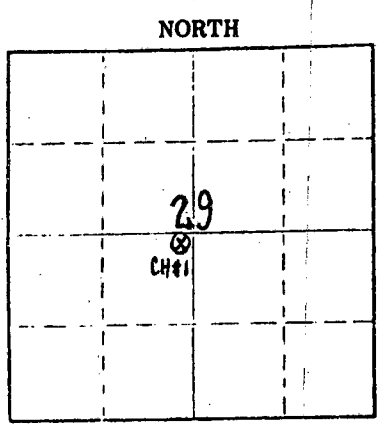

Thomas County, Sec. 29 Twp 8 S. Rge. 32 W. (W)  
Location as "NE/CNW/SE" or footage from lines 2500' N. and 2480' E. of the SW corner  
Lease Owner Murfin Drilling Co.  
Lease Name Baker Well No. CH #1  
Office Address 617 Union Center - Wichita, Kansas 67202  
Character of Well (completed as Oil, Gas or Dry Hole) core hole  
Date well completed July 8 1976  
Application for plugging filed July 15 1976  
Application for plugging approved 1976  
Plugging commenced July 9 1976  
Plugging completed July 9 1976  
Reason for abandonment of well or producing formation core hole

If a producing well is abandoned, date of last production 1976  
Was permission obtained from the Conservation Division or its agents before plugging was commenced? Yes - we called Mr. Gilbert Balforzour - the State Plugging for this district

Locate well correctly on above Section Plot  
Name of Conservation Agent who supervised plugging of this well Gilbert Balforzour  
Producing formation \_\_\_\_\_ Depth to top \_\_\_\_\_ Bottom \_\_\_\_\_ Total Depth of Well 1260 feet  
Show depth and thickness of all water, oil and gas formations.

OIL, GAS OR WATER RECORDS

CASING RECORD

FORMATION	CONTENT	FROM	TO	SIZE	PUT IN	PULLED OUT

Describe in detail the manner in which the well was plugged, indicating where the mud fluid was placed and the method or methods used in introducing it into the hole. If cement or other plugs were used, state the character of same and depth placed, from \_\_\_\_\_ feet to \_\_\_\_\_ feet for each plug set.


5 sacks cement @ 300' pumped in with mud pump  
5 sacks cement @ 50' pumped in with mud pump

RECEIVED  
STATE CORPORATION COMMISSION  
1111 16 1976  
CONSERVATION DIVISION  
Wichita, Kansas

Name of Plugging Contractor Exploration, Inc.  
Address 610 Petroleum Bldg. - Wichita, Kansas 67202

STATE OF Kansas COUNTY OF Sedgwick  
Bill D. Ham Representative of (owner or operator) of the above-described well, being first duly sworn on oath, says: That I have knowledge of the facts, statements, and matters herein contained and the log of the above-described well as filed and that the same are true and correct. So help me God.

(Signature) Bill D. Ham  
610 Petroleum Bldg - Wichita, Kansas  
(Address)

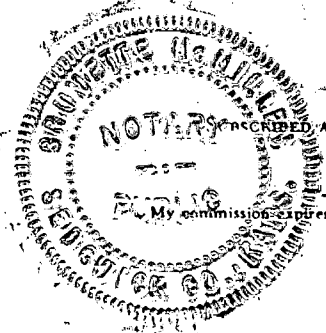

AND SWORN to before me this 15 day of July, 1976  
Brigitte McMillen  
Notary Public.