


Get All Information Completely
Make Required Affidavit
Mail or Deliver Report to:
Conservation Division
State Corporation Commission
212 No. Market
Wichita, Kansas

WELL PLUGGING RECORD

Thomas County, Sec. 32 Twp. 8S Rge. 32 (E) (W)

Location as "NE/CNW/SW" or footage from lines C SW NW
Lease Owner Mull Drilling Company, Inc.
Lease Name SADDLER Well No. 1
Office Address 1625 Wichita Plaza - Wichita, Kansas
Character of Well (completed as Oil, Gas or Dry Hole) Dry Hole
Date well completed 11-8 19 68
Application for plugging filed 11-8 19 68
Application for plugging approved 11-8 19 68
Plugging commenced 11-8 19 68
Plugging completed 7:45 PM 11-8 19 68
Reason for abandonment of well or producing formation No oil or gas found in commercial quantities.
If a producing well is abandoned, date of last production 19
Was permission obtained from the Conservation Division or its agents before plugging was commenced? Yes

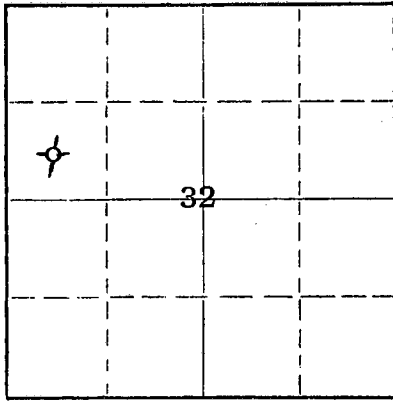

Locate well correctly on above Section Plat

Name of Conservation Agent who supervised plugging of this well Bill Nichols, Morland, Kansas
Producing formation _____ Depth to top _____ Bottom _____ Total Depth of Well 4402 Feet
Show depth and thickness of all water, oil and gas formations.

OIL, GAS OR WATER RECORDS

CASING RECORD

FORMATION	CONTENT	FROM	TO	SIZE	PUT IN	PULLED OUT
				8-5/8"	276'	-0-

Describe in detail the manner in which the well was plugged, indicating where the mud fluid was placed and the method or methods used in introducing it into the hole. If cement or other plugs were used, state the character of same and depth placed, from _____ feet to _____ feet for each plug set.

Spotted 100 cu.ft. 50-50 Pozmix, 6% gel, at 2250'.
Spotted 20 sacks same at 310'. Set solid bridge at 40' and capped with 10 sacks.

RECEIVED
STATE CORPORATION COMMISSION
NOV 14 1968
CONSERVATION DIVISION
Wichita, Kansas

11-14-68

(If additional description is necessary, use BACK of this sheet)
Name of Plugging Contractor Rains & Williamson Oil Co., Inc.
Address 1425 Wichita Plaza - Wichita, Kansas 67202


STATE OF KANSAS, COUNTY OF SEDGWICK, ss.
Wilson Rains (employee of owner) or (owner or operator) of the above-described

well, being first duly sworn on oath, says: That I have knowledge of the facts, statements, and matters herein contained and the log of the above-described well as filed and that the same are true and correct. So help me God.

(Signature) Wilson Rains Wilson Rains
1425 Wichita Plaza - Wichita, Kansas
(Address)

SUBSCRIBED AND SWORN to before me this 12 day of November 19 68

My commission expires June 30, 1971
Sherry Gish Notary Public.

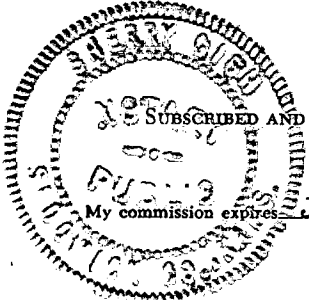

15-193-20007-0000

ROTARY DRILLING LOG

Operator: Mull Drilling Company, Inc.
SADDLER #1
C SW NW 32-8S-32W
Thomas County, Kansas

Contractor: Rains & Williamson
Oil Co., Inc.
Commenced: 10-30-68
Completed: 11-8-68

Casing: 8-5/8" @ 276'/200 sx.
GL-3.

Formations

Clay	20'
Sand	25'
Clay and Sand	95'
Sand	105'
Sand and Clay	240'
Shale	975'
Shale and Shells	1700'
Shale	2200'
Shale, Shells & Sand	2370'
Red Bed and Shale	2690'
Shale and Red Bed	2709'
Anhydrite	2738'
Shale	2918'
Shale and Red Bed & Lime	3118'
Shale and Lime	3375'
Lime	3460'
Lime and Shale	3735'
Lime	3813'
Shale and Lime	3875'
Lime and Shale	3588'
Shale, Lime & Chert	3663'
Lime	3735'
Lime and Shale	4052'
Shale and Lime	4101'
Lime and Shale	4203'
Lime	4402'
Rotary Total Depth (D&A)	4402'

RECEIVED
STATE CORPORATION COMMISSION
NOV 14 1968
CONSERVATION DIVISION
Wichita, Kansas

11-14-68

We certify the above log is true and correct to the best of our knowledge and belief.

RAINS & WILLIAMSON OIL CO., INC.

Wilson Rains
Wilson Rains



Subscribed and sworn to before me, a Notary Public within and for the State of Kansas, County of Sedgwick, this 12th day of November, 1968.

Sherry Gish
Sherry Gish Notary Public

My Commission Expires: 6-30-71