

STATE OF KANSAS  
STATE CORPORATION COMMISSION

Give All Information Completely  
Make Required Affidavit  
Mail or Deliver Report to:  
Conservation Division  
State Corporation Commission  
800 Bitting Building  
Wichita, Kansas

OR  
~~FORMATION PLUGGING RECORD~~  
Strike out upper line when reporting plugging off formations.

Thomas County, Sec. 33 Twp. 8S Rge. 32 (W)

Location as "NE 1/4 NW 1/4 SW 1/4" or footage from lines. NE/4 NE/4 NE/4

Lease Owner Ashland Oil & Refining Company

Lease Name Edward L. Misner Well No. 1

Office Address Box 1127, Oklahoma City, Oklahoma

Character of Well (completed as Oil, Gas or Dry Hole) Dry Hole

Date well completed 12-11 19 52

Application for plugging filed 12-11 19 52

Application for plugging approved 12-11 19 52


Plugging commenced 12-12 19 52

Plugging completed 12-12 19 52

Reason for abandonment of well or producing formation Dry Hole

If a producing well is abandoned, date of last production 19

Was permission obtained from the Conservation Division or its agents before plugging was commenced? Yes

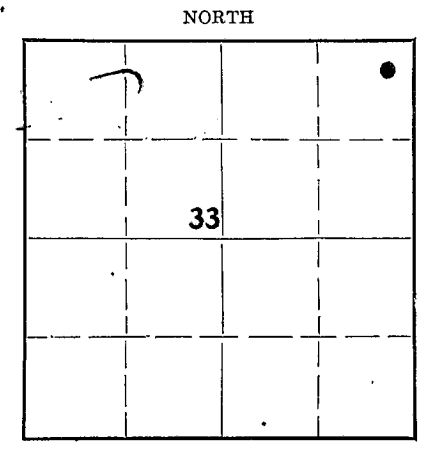

Locate well correctly on above Section Plat

Name of Conservation Agent who supervised plugging of this well Eldon Petty  
Producing formation None Depth to top Bottom Total Depth of Well 5033 Feet

Show depth and thickness of all water, oil and gas formations.

OIL, GAS OR WATER RECORDS

1-7-53

CASING RECORD

Formation	Content	From	To	Size	Put In	Pulled Out
None				8-5/8"	230'	None

RECEIVED  
STATE CORPORATION COMMISSION  
JAN 7 1953  
CONSERVATION DIVISION

Describe in detail the manner in which the well was plugged, indicating where the mud fluid was placed and the method or methods used in introducing it into the hole. If cement or other plugs were used, state the character of same and depth placed, from feet to feet for each plug set.

Heavy drilling mud from total depth to 210', then 15 sax cement plug at 210'. Heavy rotary mud to 40'. Filled surface casing from 40' to well cellar with cement.

(If additional description is necessary, use BACK of this sheet)  
Correspondence regarding this well should be addressed to Ashland Oil & Refining Company  
Address Box 1127, Oklahoma City, Oklahoma

STATE OF Oklahoma, COUNTY OF Oklahoma, SS. A. G. Burki (employee of owner) or (owner) of the above-described well,

being first duly sworn on oath, says: That I have knowledge of the facts, statements, and matters herein contained and the log of the above-described well as filed and that the same are true and correct. So help me God.

(Signature) A. G. Burki, Division Production Superintendent  
Ashland Oil & Refg. Co., Box 1127, Okla. City, Okla.

SUBSCRIBED AND SWORN TO before me this 6th day of January, 19 53

Notary Public

My commission expires 8-8-55

PLUGGING  
FILE SEC 33 T 8 R 32  
BOOK PAGE 66 LINE 23